


PA ONE CALL SYSTEM INC. PHONE NO. 1-800-242-1776
SERIAL #20161591676 MOON TOWNSHIP SEPTEMBER 16, 2016

D	COMCAST CABLEVISION 183 SPRING RUN RD EXT BLDG 1A CORAOPOLIS, PA. 15108 CONTACT: RAYMOND JONES EMAIL: raymond_jones@cable.comcast.com
S	MOON TOWNSHIP MUNICIPAL AUTHORITY 1700 BEAVER GRADE RD MOON TOWNSHIP, PA. 15108 CONTACT: JOANNE SCHULENBURG
G	COLUMBIA GAS OF PA INC - BETHEL PARK ADDRESS: 251 W MAIDEN ST WASHINGTON, PA. 15301 CONTACT: SHANNON GRIEST EMAIL: sgriest@nlsource.com BUCKEYE PARTNERS FIVE TEK PARK 9999 HAMILTON BLVD BREINIGSVILLE, PA. 18031 CONTACT: DAVE JONES EMAIL: DAJONES@BUCKEYE.COM
G1	

LIMIT OF WORK
STA 200+00.00
SEG 0720 OFFSET 760
SR 0051
MOON TOWNSHIP
ALLEGHENY COUNTY

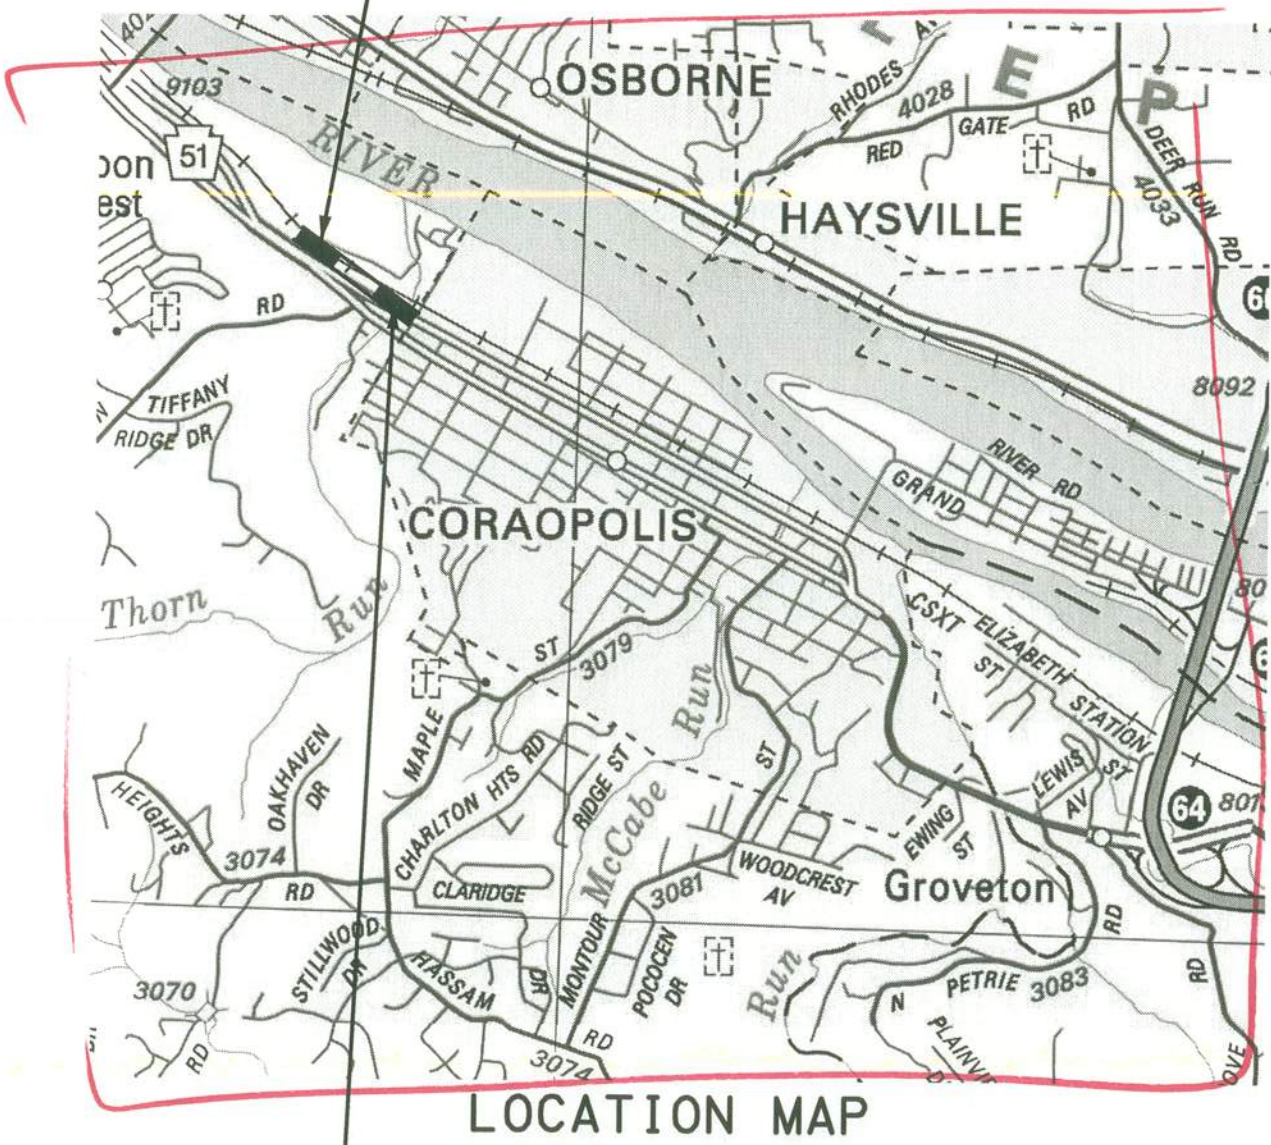

LEGEND

- EXPRESSWAY
- STATE ROUTE
- LOCAL ROADS
- TOWNSHIP LINE
- PROJECT



LIMIT OF WORK
STA 277+67.55
SEG 0730 OFFSET 1858
SR 0051
MOON TOWNSHIP
ALLEGHENY COUNTY

SUMMARY OF PROJECT COORDINATES

RTE.	STATION	POINT	COORDINATES		BEARING
			NORTH	EAST	
	200+00.00	BEGIN STA	442802.8620	1293896.7467	N 28° 18' 08" E
	200+20.94	PC	442821.3024	1293906.6767	N 28° 18' 08" E
	200+39.94	PI	442838.0281	1293915.6835	N 58° 45' 00" W
	200+51.33	PT	442847.8831	1293899.4430	N 58° 45' 00" W
	204+10.07	PC	443033.9867	1293592.7525	N 58° 45' 00" W
	204+52.03	PI	443055.7554	1293556.8786	N 13° 13' 20" W
	204+89.53	PT	443096.6051	1293547.2807	N 13° 13' 20" W
	204+94.03	PC	443100.9894	1293546.2506	N 13° 13' 20" W
	205+38.54	PI	443144.3190	1293536.0700	N 61° 12' 34" W
	205+77.79	PT	443165.7552	1293497.0623	N 61° 12' 34" W
	207+40.37	PC	443244.0569	1293354.5759	N 61° 12' 34" W
	207+64.52	PI	443255.6883	1293333.4099	N 74° 58' 50" W
	207+88.44	PT	443261.9471	1293310.0836	N 74° 58' 50" W
	208+03.99	PC	443265.9765	1293295.0658	N 74° 58' 50" W
	208+39.67	PI	443275.2215	1293260.6097	N 61° 25' 03" W
	208+75.01	PT	443292.2892	1293229.2826	N 61° 25' 03" W
	209+52.22	PC	443329.2289	1293161.4809	N 61° 25' 03" W
	209+70.08	PI	443337.7732	1293145.7983	N 32° 47' 33" W
	209+87.19	PT	443352.7862	1293136.1259	N 32° 47' 33" W
	210+00.59	PC	443364.0506	1293128.8686	N 32° 47' 33" W
	210+30.67	PI	443389.3334	1293112.5797	N 79° 17' 40" W
	210+57.40	PT	443394.9204	1293083.0274	N 79° 17' 40" W
	210+70.50	PC	443397.3541	1293070.1546	N 79° 17' 40" W
	210+88.09	PI	443400.6212	1293052.8734	N 59° 20' 41" W
	211+05.32	PT	443409.5884	1293037.7439	N 59° 20' 41" W
	212+34.81	PC	443475.6125	1292926.3483	N 59° 20' 41" W
	212+83.76	PI	443500.5665	1292884.2462	N 53° 44' 27" W
	213+32.62	PT	443529.5124	1292844.7820	N 53° 44' 27" W
	214+99.34	PC	443628.1192	1292710.3439	N 53° 44' 27" W
	215+91.99	PI	443682.9143	1292635.6376	N 64° 19' 38" W
	216+84.11	PT	443723.0519	1292552.1359	N 64° 19' 38" W
	217+98.35	PC	443772.5449	1292449.1713	N 64° 19' 38" W
	219+12.21	PI	443821.8706	1292346.5549	N 22° 45' 43" W
	220+15.99	PT	443926.8593	1292302.5039	N 22° 45' 43" W
	220+33.62	PC	443943.1166	1292295.6826	N 22° 45' 43" W
	221+36.64	PI	444038.1112	1292255.8249	N 46° 02' 45" W
	222+36.81	PT	444109.6137	1292181.6629	N 46° 02' 45" W
	227+65.81	END STA	444476.7818	1291800.8381	

NOTE: COORDINATES TO FOUR DECIMAL PLACES ARE FOR COMPUTATIONAL PURPOSES ONLY AND TO NOT IMPLY A PRECISION BEYOND TWO DECIMAL PLACES.

DISTRICT	COUNTY	ROUTE	SECTION	SHEET
11-0	ALLEGHENY	0051	A93 R/W	3 OF 14
MOON TOWNSHIP				
REVISION NUMBER	REVISIONS			DATE

GENERAL NOTES:

THE EXISTING LEGAL RIGHT OF WAY IS VARIABLE IN WIDTH ON S.R. 0051 FORMERLY KNOWN AS L.R. 76, MOON TOWNSHIP, ALLEGHENY COUNTY FROM STA. 595+16 SOUTHBOUND (S.D. STA. 595+33) TO STA. 641+38 SOUTHBOUND (S.L.D. STA 642+48) IN ACCORDANCE WITH THE CONSTRUCTION PLAN FOR L.R. 67 SECTION 10, APPROVED JULY 2, 1953 IN THE ALLEGHENY RECORDERS OFFICE IN STATE HIGHWAY PLAN BOOK II, PAGES 13 TO 21.

PRIVATE PROPERTY LINES ARE PLOTTED FROM THE DEED OF RECORD, RECORDED SUBDIVISION, OR LOT PLANS. PRIVATE PROPERTY LINES WERE NOT SURVEYED BY THE PROFESSIONAL LAND SURVEYOR RESPONSIBLE FOR THE PROJECT.

THE VERTICAL CONTROL FOR THIS PROJECT IS BASED ON THE NORTH AMERICAN VERTICAL DATUM OF 1988 (NAVD 88).

THE HORIZONTAL CONTROL FOR THIS PROJECT IS TIED TO THE PENNSYLVANIA STATE COORDINATE SYSTEM SOUTH ZONE (NAD 1983).

THE SPECIFICATIONS FOR THIS PROJECT WILL BE THOSE OF THE PENNSYLVANIA DEPARTMENT OF TRANSPORTATION STATE HIGHWAY ADMINISTRATION STANDARD SPECIFICATIONS FOR CONSTRUCTION AND MATERIALS, PUBLICATION 408, DATED 2016. IN CASE OF A DISCREPANCY BETWEEN THE SPECIAL PROVISIONS AND OTHER PROVISIONS INCLUDED IN THIS CONTRACT THE ENGINEER (WITH DEPARTMENT CONCURRENCE) WILL BE THE SOLE AUTHORITY AS TO THE PROPER PROCEDURE TO FOLLOW.

THIS IS A FEDERAL-AID PROJECT AND SUCH IS SUBJECT TO INSPECTION BY REPRESENTATIVES OF THE FEDERAL HIGHWAY ADMINISTRATION AND THE PENNSYLVANIA DEPARTMENT OF TRANSPORTATION.

ALL CURVE DATA IS BASED ON ARC DEFINITION.

TEMPORARY CONSTRUCTION EASEMENT. AN EASEMENT TO USE THE LAND AS NECESSARY DURING CONSTRUCTION OF THE PROJECT. THE EASEMENT IS REQUIRED ONLY UNTIL THE CONSTRUCTION OR WORK INDICATED BY THE PLAN IS COMPLETED, UNLESS SOONER RELINQUISHED IN WRITING BY THE DEPARTMENT.

ALL CONSTRUCTION WORK, WITHIN THE STATE RIGHT OF WAY (ROW) AND WITHIN THE FEDERAL LIMITED ACCESS ROW, IS TO BE CONSTRUCTED IN CONFORMANCE WITH THE MAINTENANCE AND PROTECTION OF TRAFFIC (MPT) STANDARDS USING PUBLICATION 213; FIGURES PATA 5 AND PATA 10A.

SLOPE LIMITS SHOWN ON THIS PLAN ARE INDICATED AS FOLLOWS




THE HALF CIRCLED NUMBER INDICATES A SCALED DIMENSION.


Free Simplex Note

1 year note

All Revisions have been made.

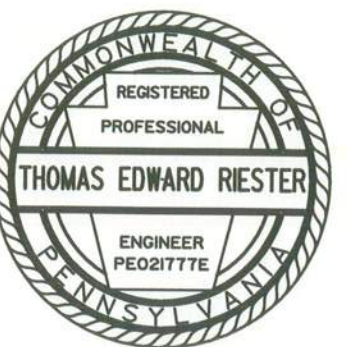


DISTRICT	COUNTY	ROUTE	SECTION	SHEET
11-0	ALLEGHENY	0051	A93	4 OF 14
BOROUGH OF CORAPOLIS				
REVISION NUMBER	REVISIONS			DATE

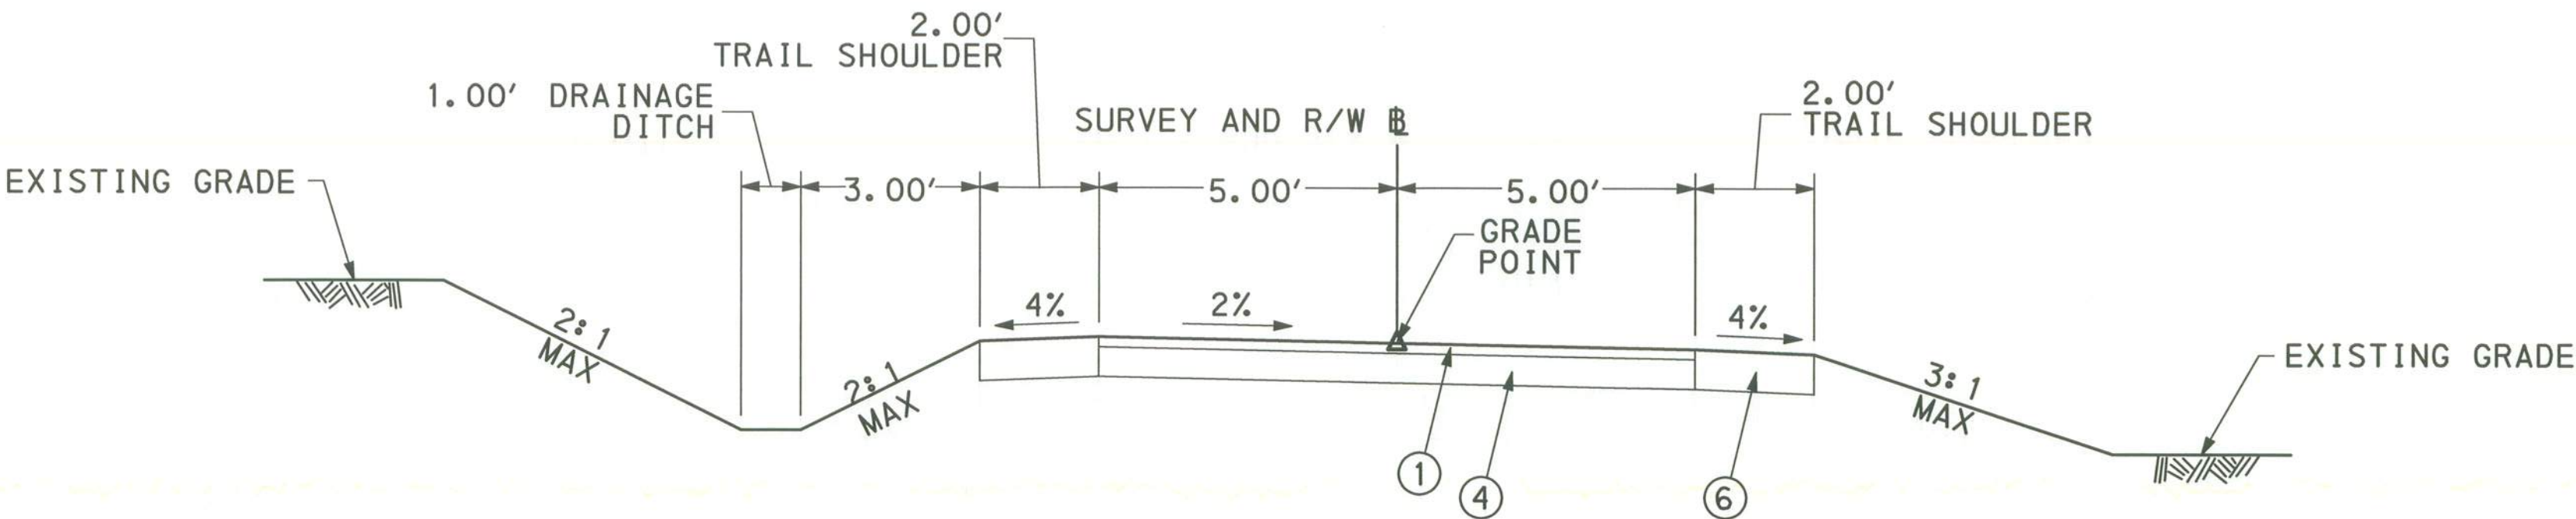


SHARED-USE TRAIL - TYPICAL SECTION
STA 200+20.00 TO STA 205+35.00
NOT TO SCALE


- ① AASHTO #10 CRUSHED LIMESTONE, 2" DEPTH
- ② SUPERPAVE ASPHALT MIXTURE DESIGN, HMA WEARING COURSE, PG 64-22, 9.5 MM MIX, 1 1/2" DEPTH
- ③ SUPERPAVE ASPHALT MIXTURE DESIGN, HMA BINDER COURSE, PG 64-22, 19 MM MIX, 2" DEPTH
- ④ SUBBASE, 6" DEPTCH (NO. 2A)
- ⑤ SUBBASE, 4" DEPTH (NO. 2A)
- ⑥ NO. 2A COURSE AGGREGATE, 8" DEPTH

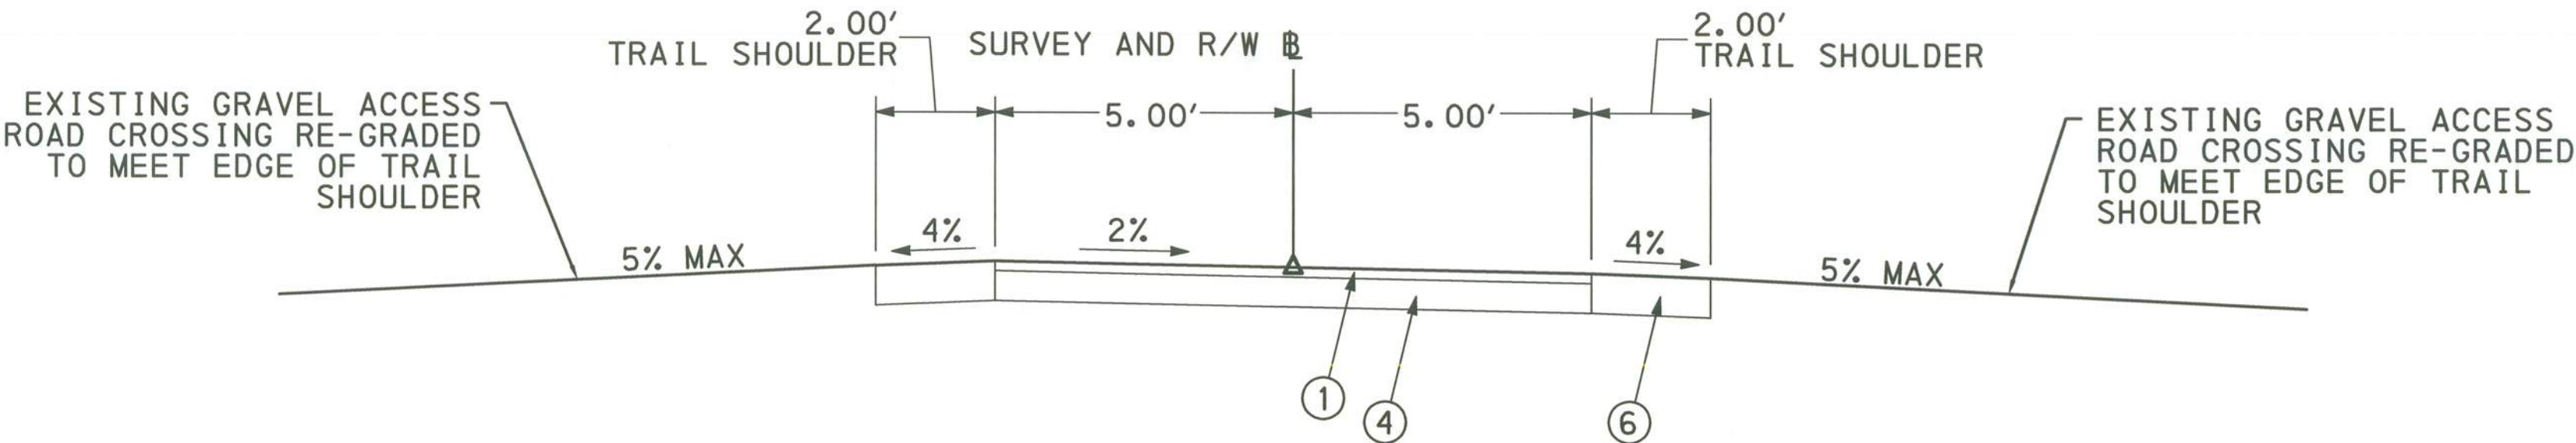


SHARED-USE TRAIL - TYPICAL SECTION
STA 205+35.00 TO STA 205+50.00
NOT TO SCALE

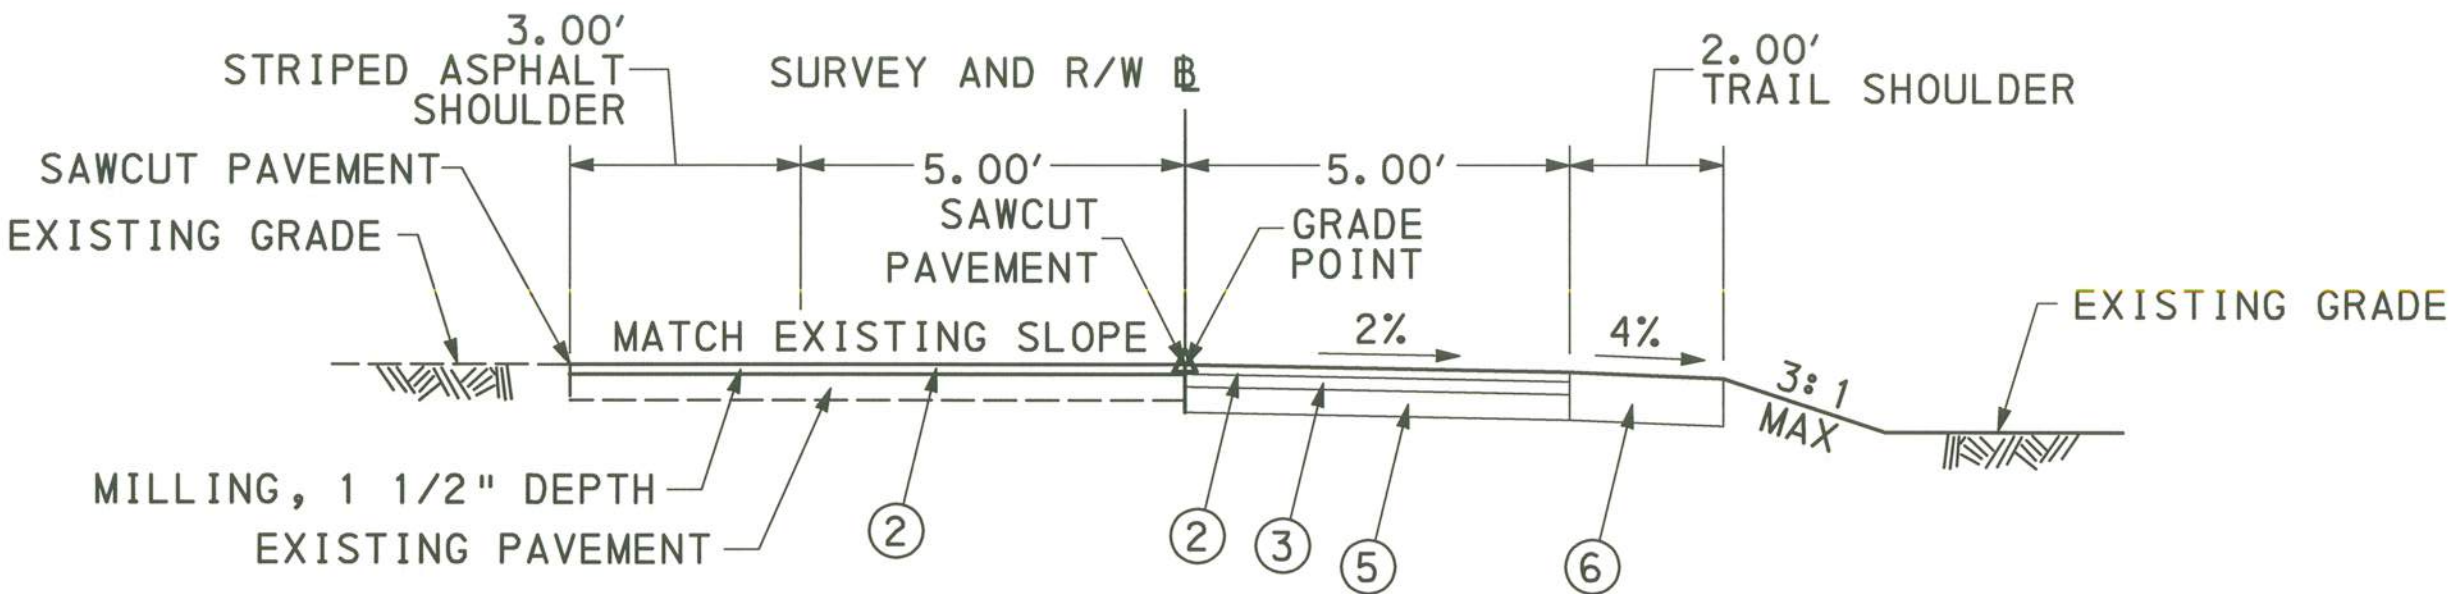


SHARED-USE TRAIL - TYPICAL SECTION
STA 224+87.00 TO STA 226+91.00
NOT TO SCALE

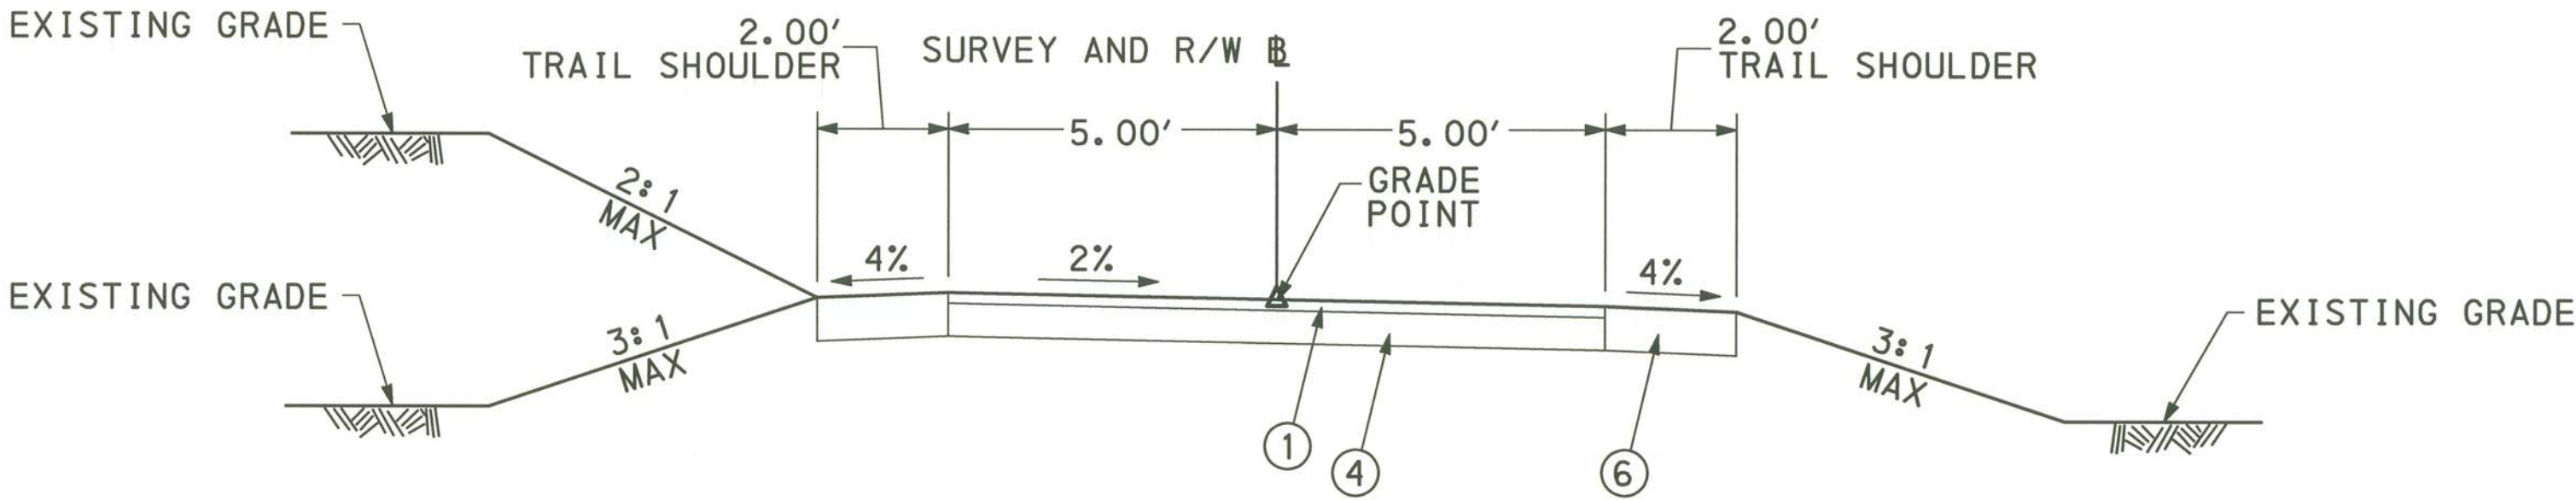

SHARED-USE TRAIL - TYPICAL SECTION
STA 205+50.00 TO STA 209+03.21
STA 209+42.30 TO 223+97.00
NOT TO SCALE

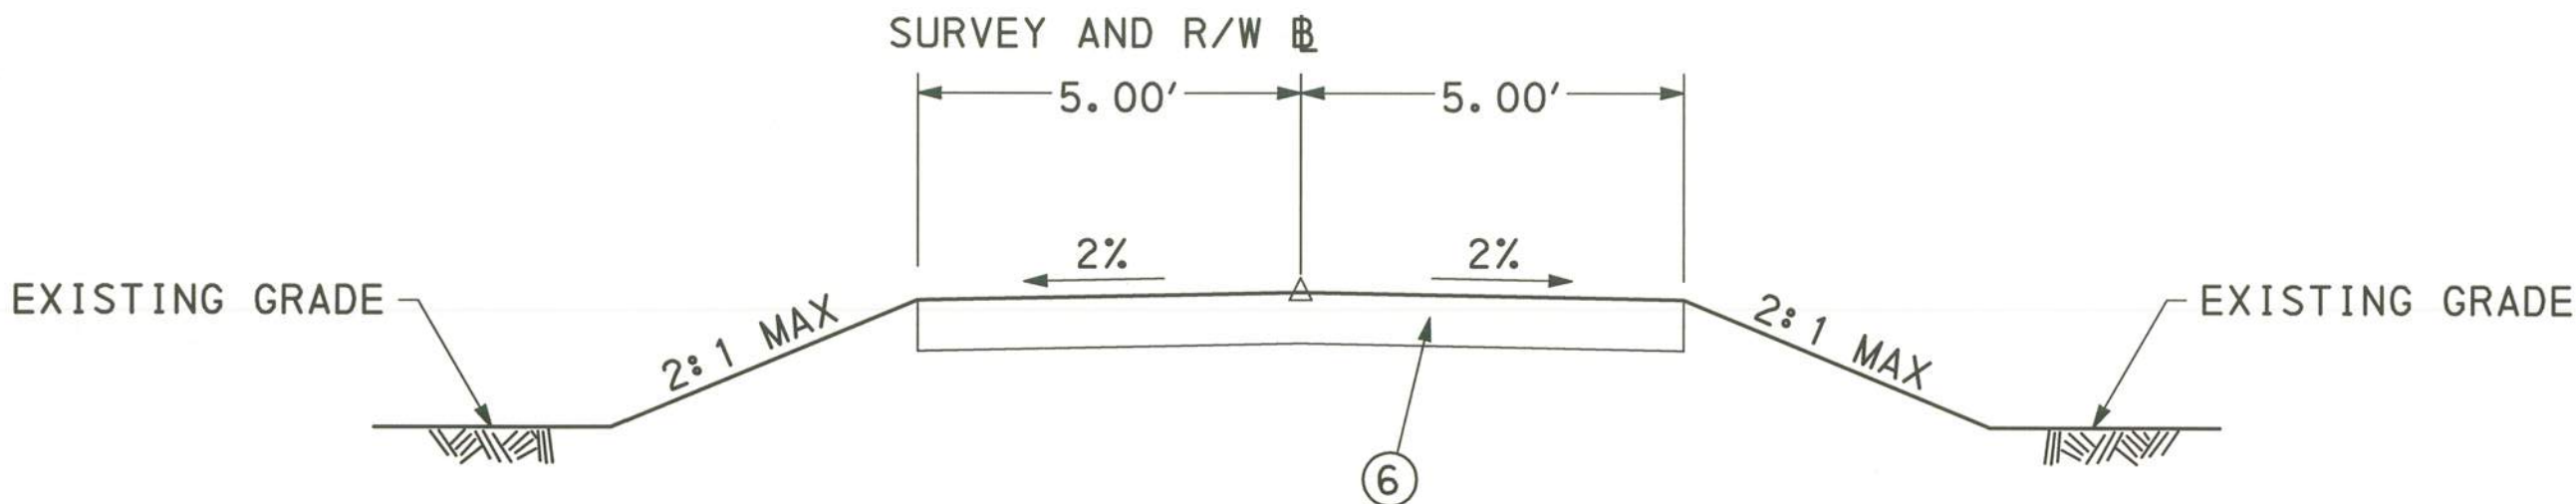

GRAVEL ACCESS ROAD - TYPICAL SECTION
STA 1000+00.00 TO STA 1001+47.09
NOT TO SCALE

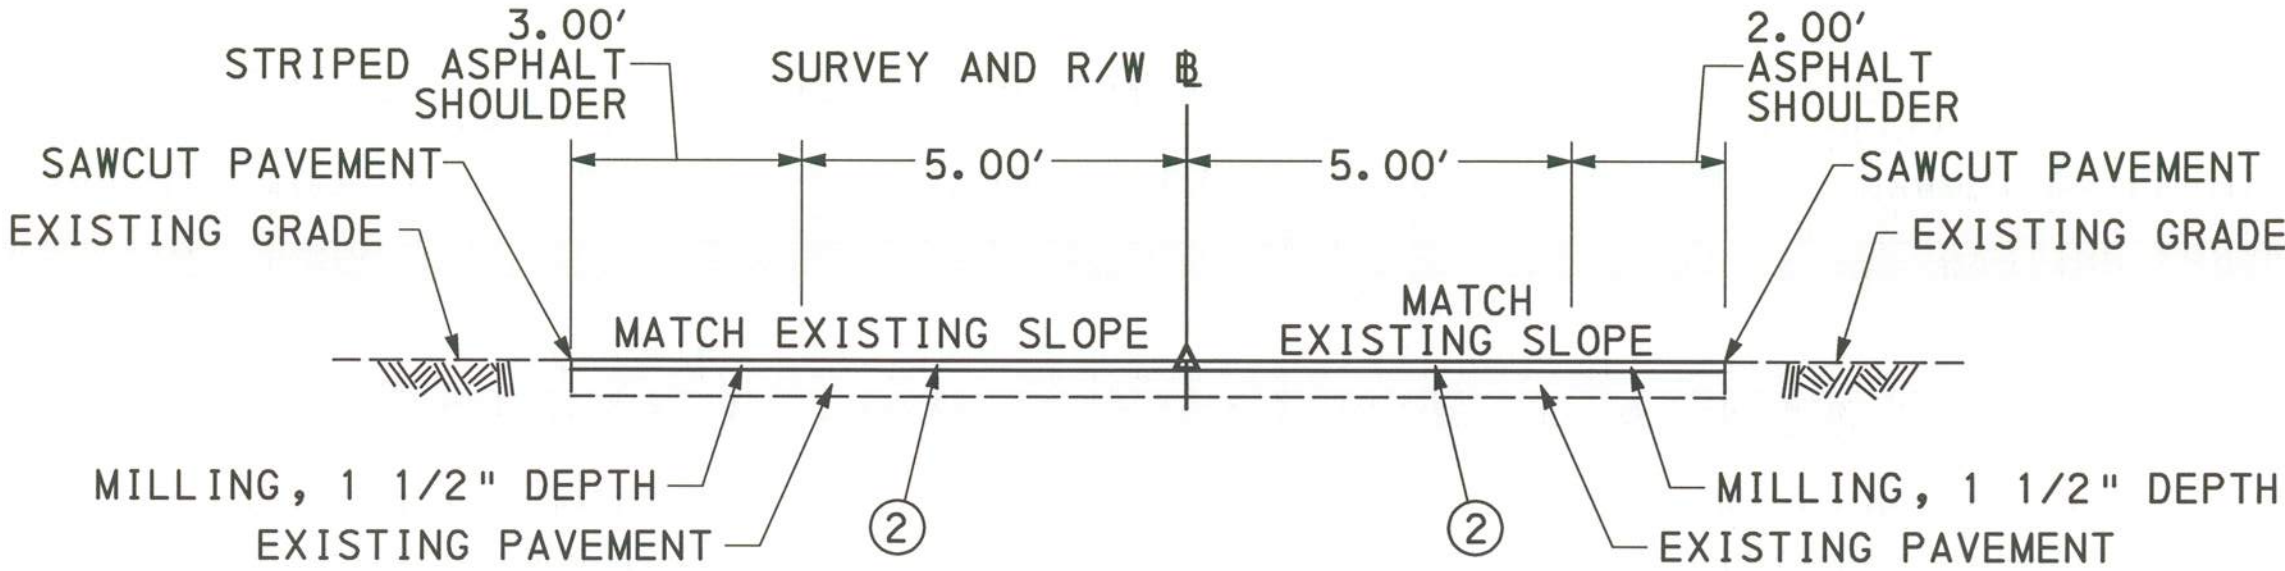

SHARED-USE TRAIL - TYPICAL SECTION
STA 223+97.00 TO STA 224+87.00
STA 226+91.00 TO 227+67.55
NOT TO SCALE

TYPICAL SECTIONS




DISTRICT	COUNTY	ROUTE	SECTION	SHEET
11-0	ALLEGHENY	0051	A93 R/W	5 OF 14
MOON TOWNSHIP				
REVISION NUMBER	REVISIONS	DATE	BY	

TRAIL CURVE DATA
PI STA 200+39.94
 $\Delta = 87^\circ 08' 03''$ LT
T = 19.00'
L = 30.39'
R = 20.00'
E = 7.58'
PC STA 200+20.94
PT STA 200+51.33

LIMIT OF WORK
STA 200+00.00
SEG 0720 OFFSET 760
SHARED-USE TRAIL
MOON TOWNSHIP
ALLEGHENY COUNTY

Has been revised
to Limit of
Authorization.

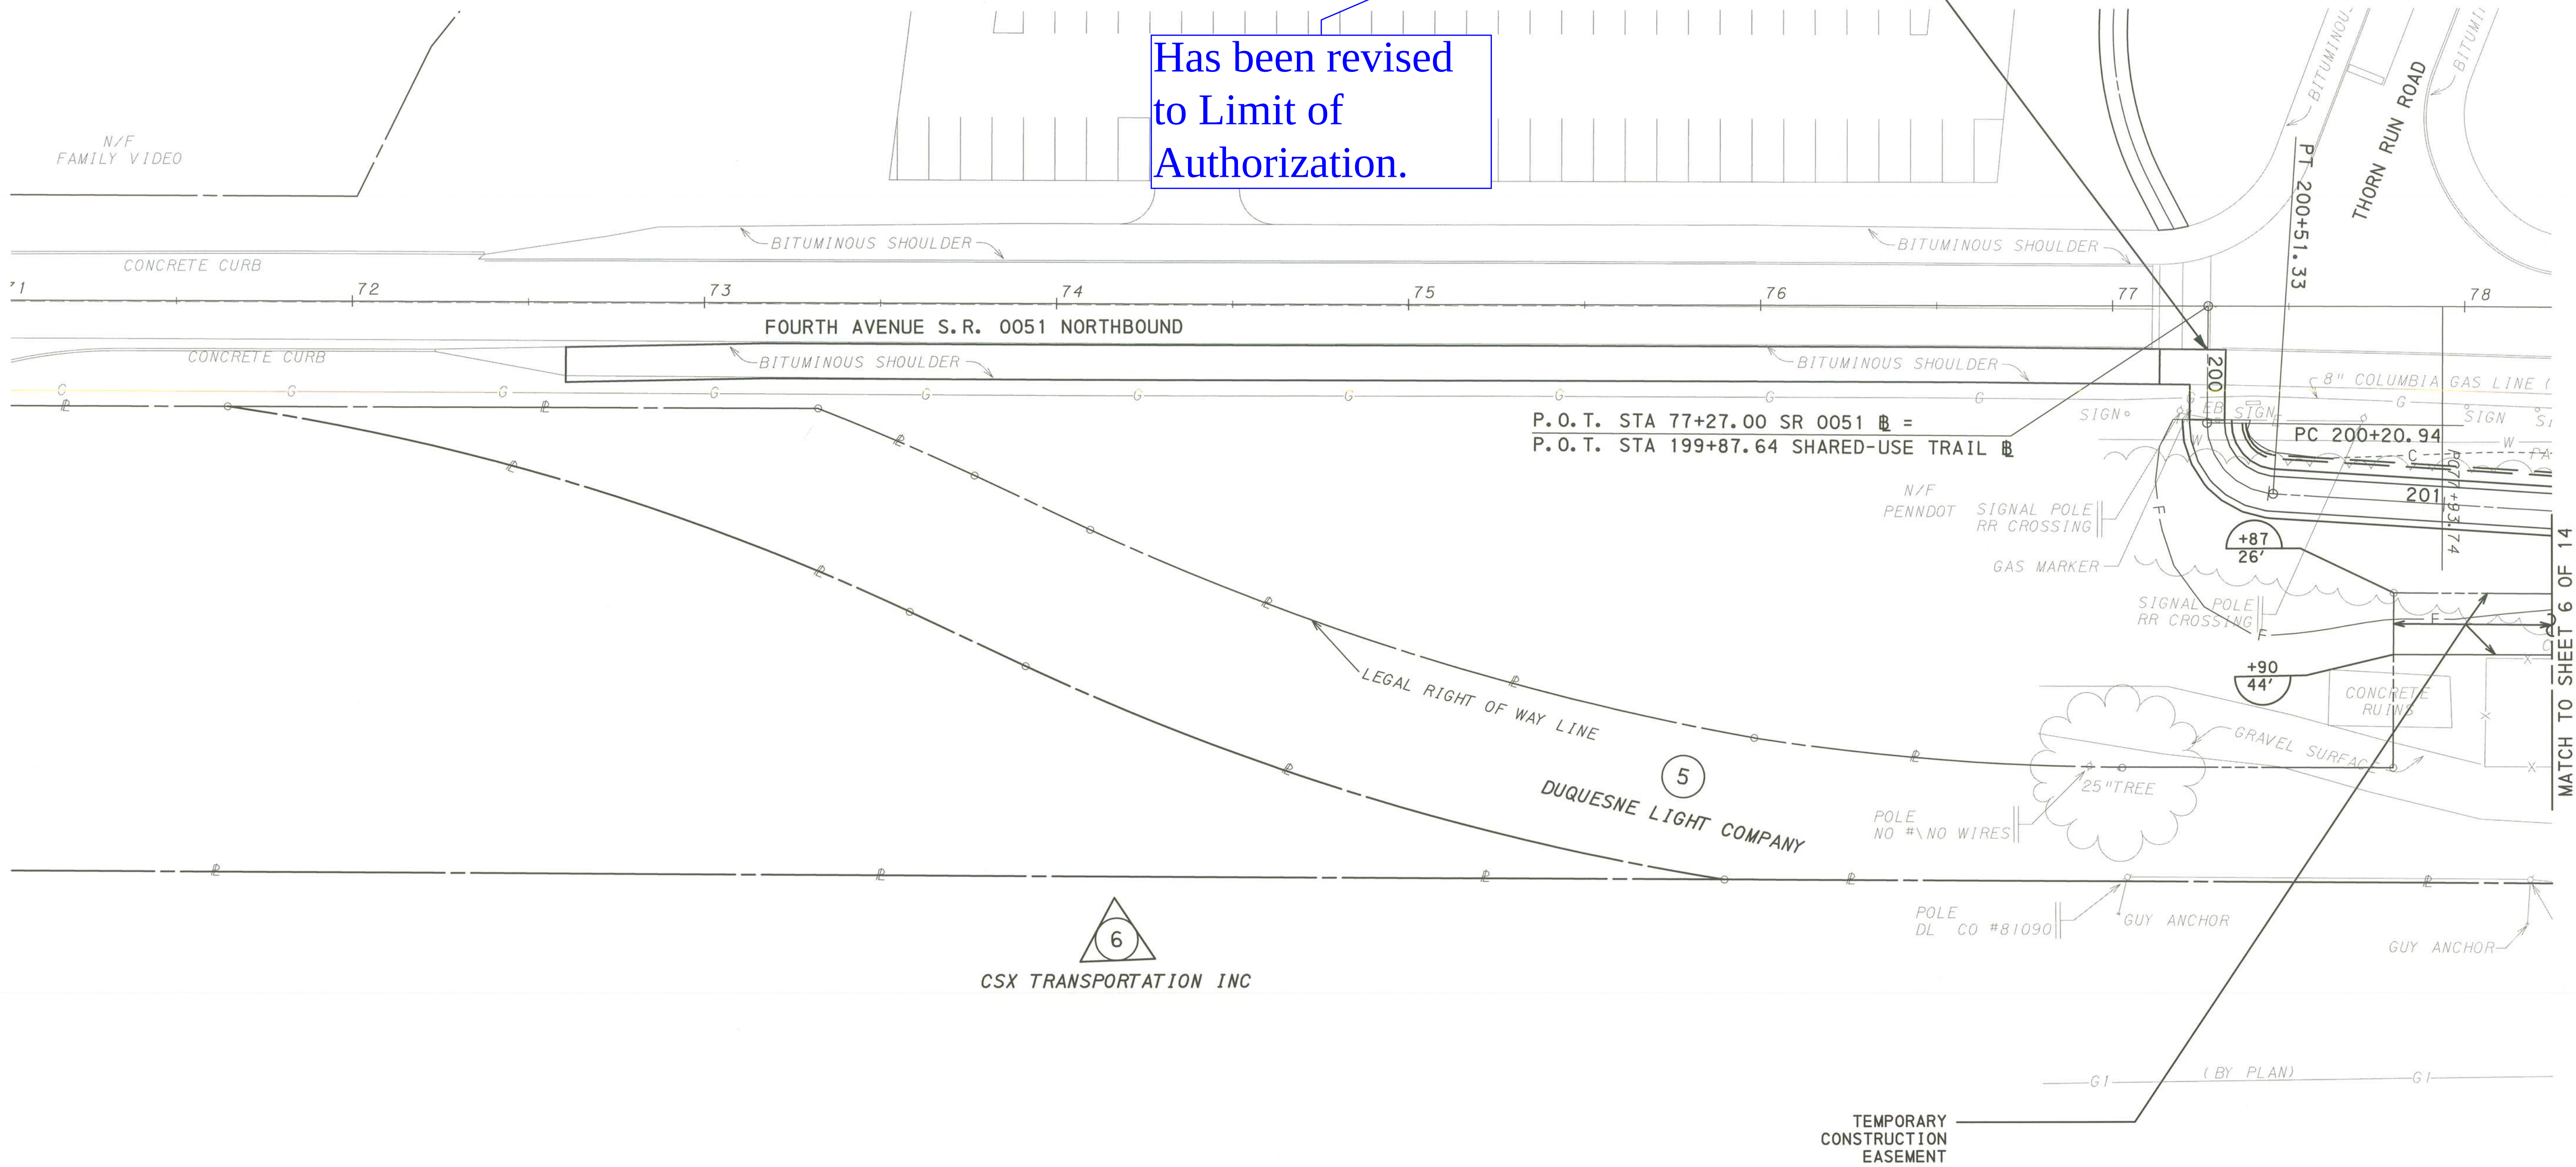


LEGEND

- | | | |
|----------------------|---------------------|--|
| - G - GAS LINE | - GV - GAS VALVE | - MH - MANHOLE |
| - D - DATA LINE | - GM - GAS METER | - LS - LIGHT STANDARD |
| - T - TELEPHONE LINE | - CO - CLEAN OUT | - WB - WATER BOX |
| - E - ELECTRIC LINE | - FH - FIRE HYDRANT | - WV - WATER VALVE |
| - S - SANITARY SEWER | - EB - ELECTRIC BOX | - EC - EXISTING CONTOURS |
| - SS - STORM SEWER | - UG - UNDERGROUND | - EC - EXISTING CONDITIONS (PAVEMENTS, WALKS, CURBS, ETC.) |
| | | - PI - PROPOSED IMPROVEMENTS |

SCALE IN FEET
0 25 50




DISTRICT	COUNTY	ROUTE	SECTION	SHEET
11-0	ALLEGHENY	0051	A93 R/W	6 OF 14
MOON TOWNSHIP				
REVISION NUMBER	REVISIONS			DATE BY

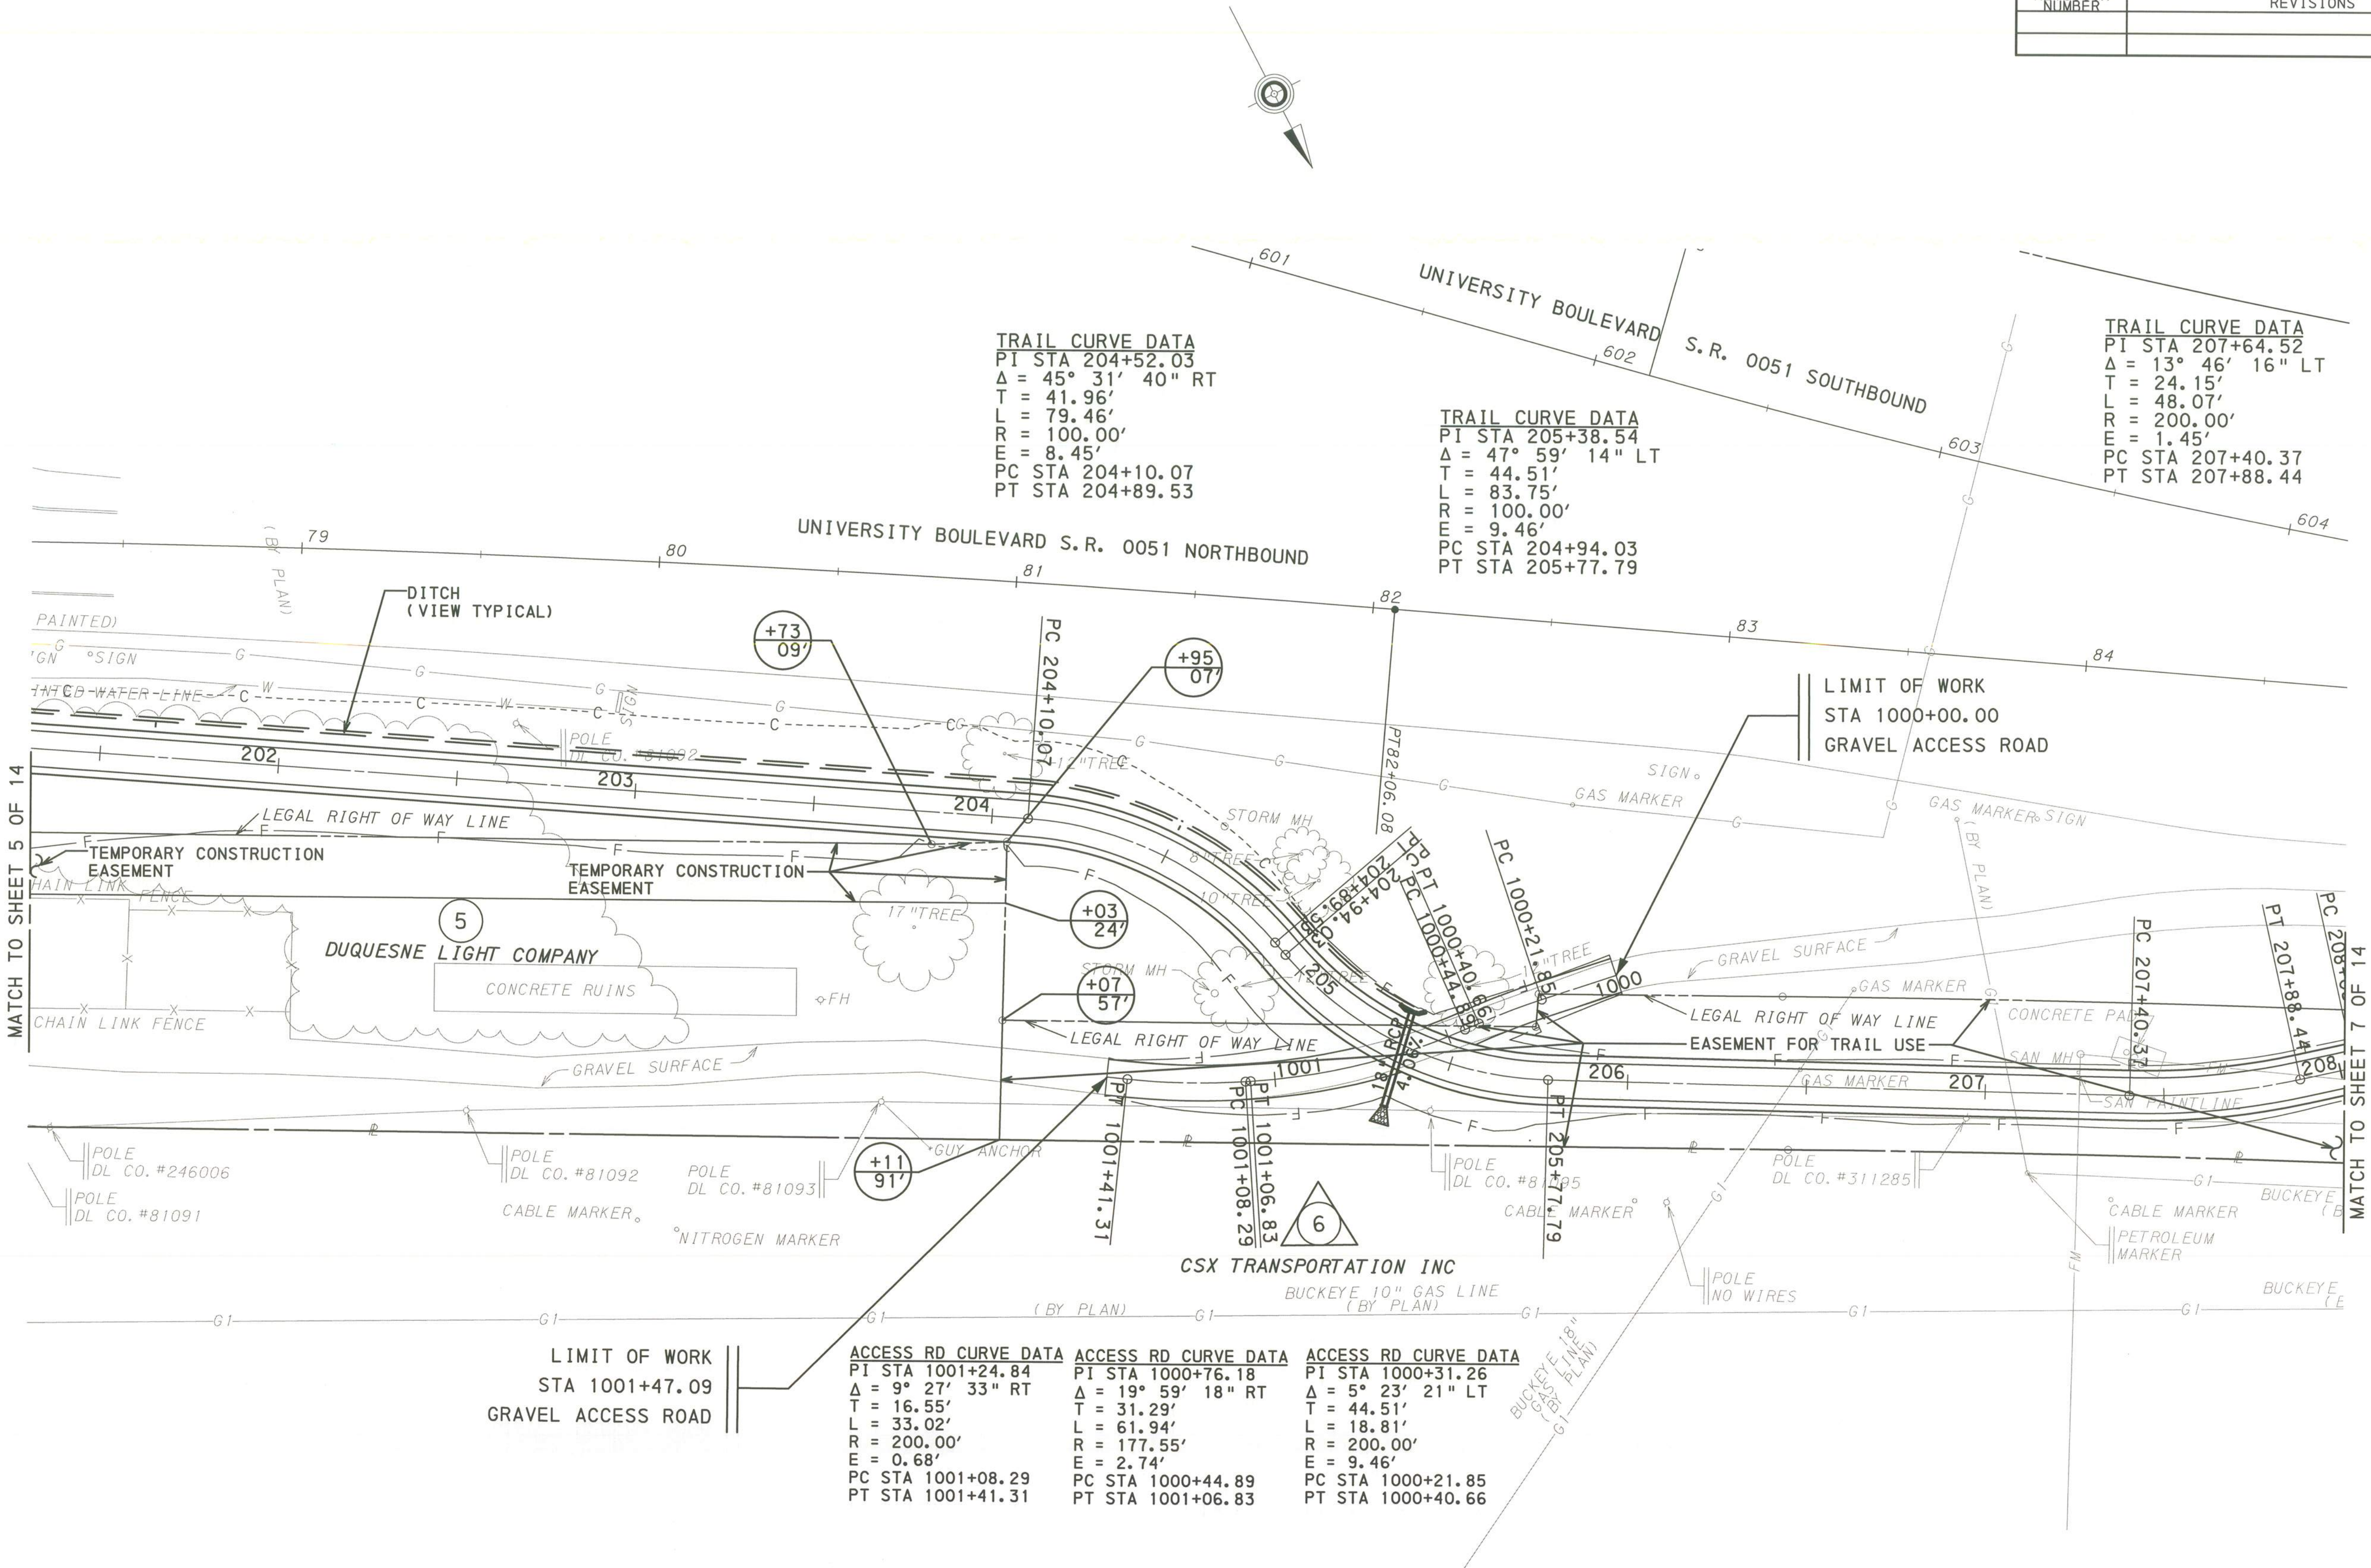


LEGEND

- | | | |
|----------------------|---------------------|--|
| - G - GAS LINE | - GV - GAS VALVE | - MH - MANHOLE |
| - D - DATA LINE | - GM - GAS METER | - LS - LIGHT STANDARD |
| - T - TELEPHONE LINE | - CO - CLEAN OUT | - WB - WATER BOX |
| - E - ELECTRIC LINE | - FH - FIRE HYDRANT | - WV - WATER VALVE |
| - S - SANITARY SEWER | - EB - ELECTRIC BOX | - EC - EXISTING CONTOURS |
| - SS - STORM SEWER | - UG - UNDERGROUND | - EX - EXISTING CONDITIONS (PAVEMENTS, WALKS, CURBS, ETC.) |
| | | - PR - PROPOSED IMPROVEMENTS |

SCALE IN FEET
0 25 50

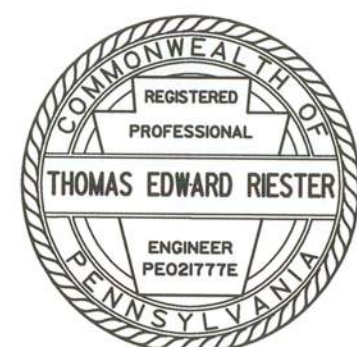

DISTRICT	COUNTY	ROUTE	SECTION	SHEET	
11-0	ALLEGHENY	0051	A93 R/W	7 OF 14	
MOON TOWNSHIP					
REVISION NUMBER	REVISIONS			DATE	BY


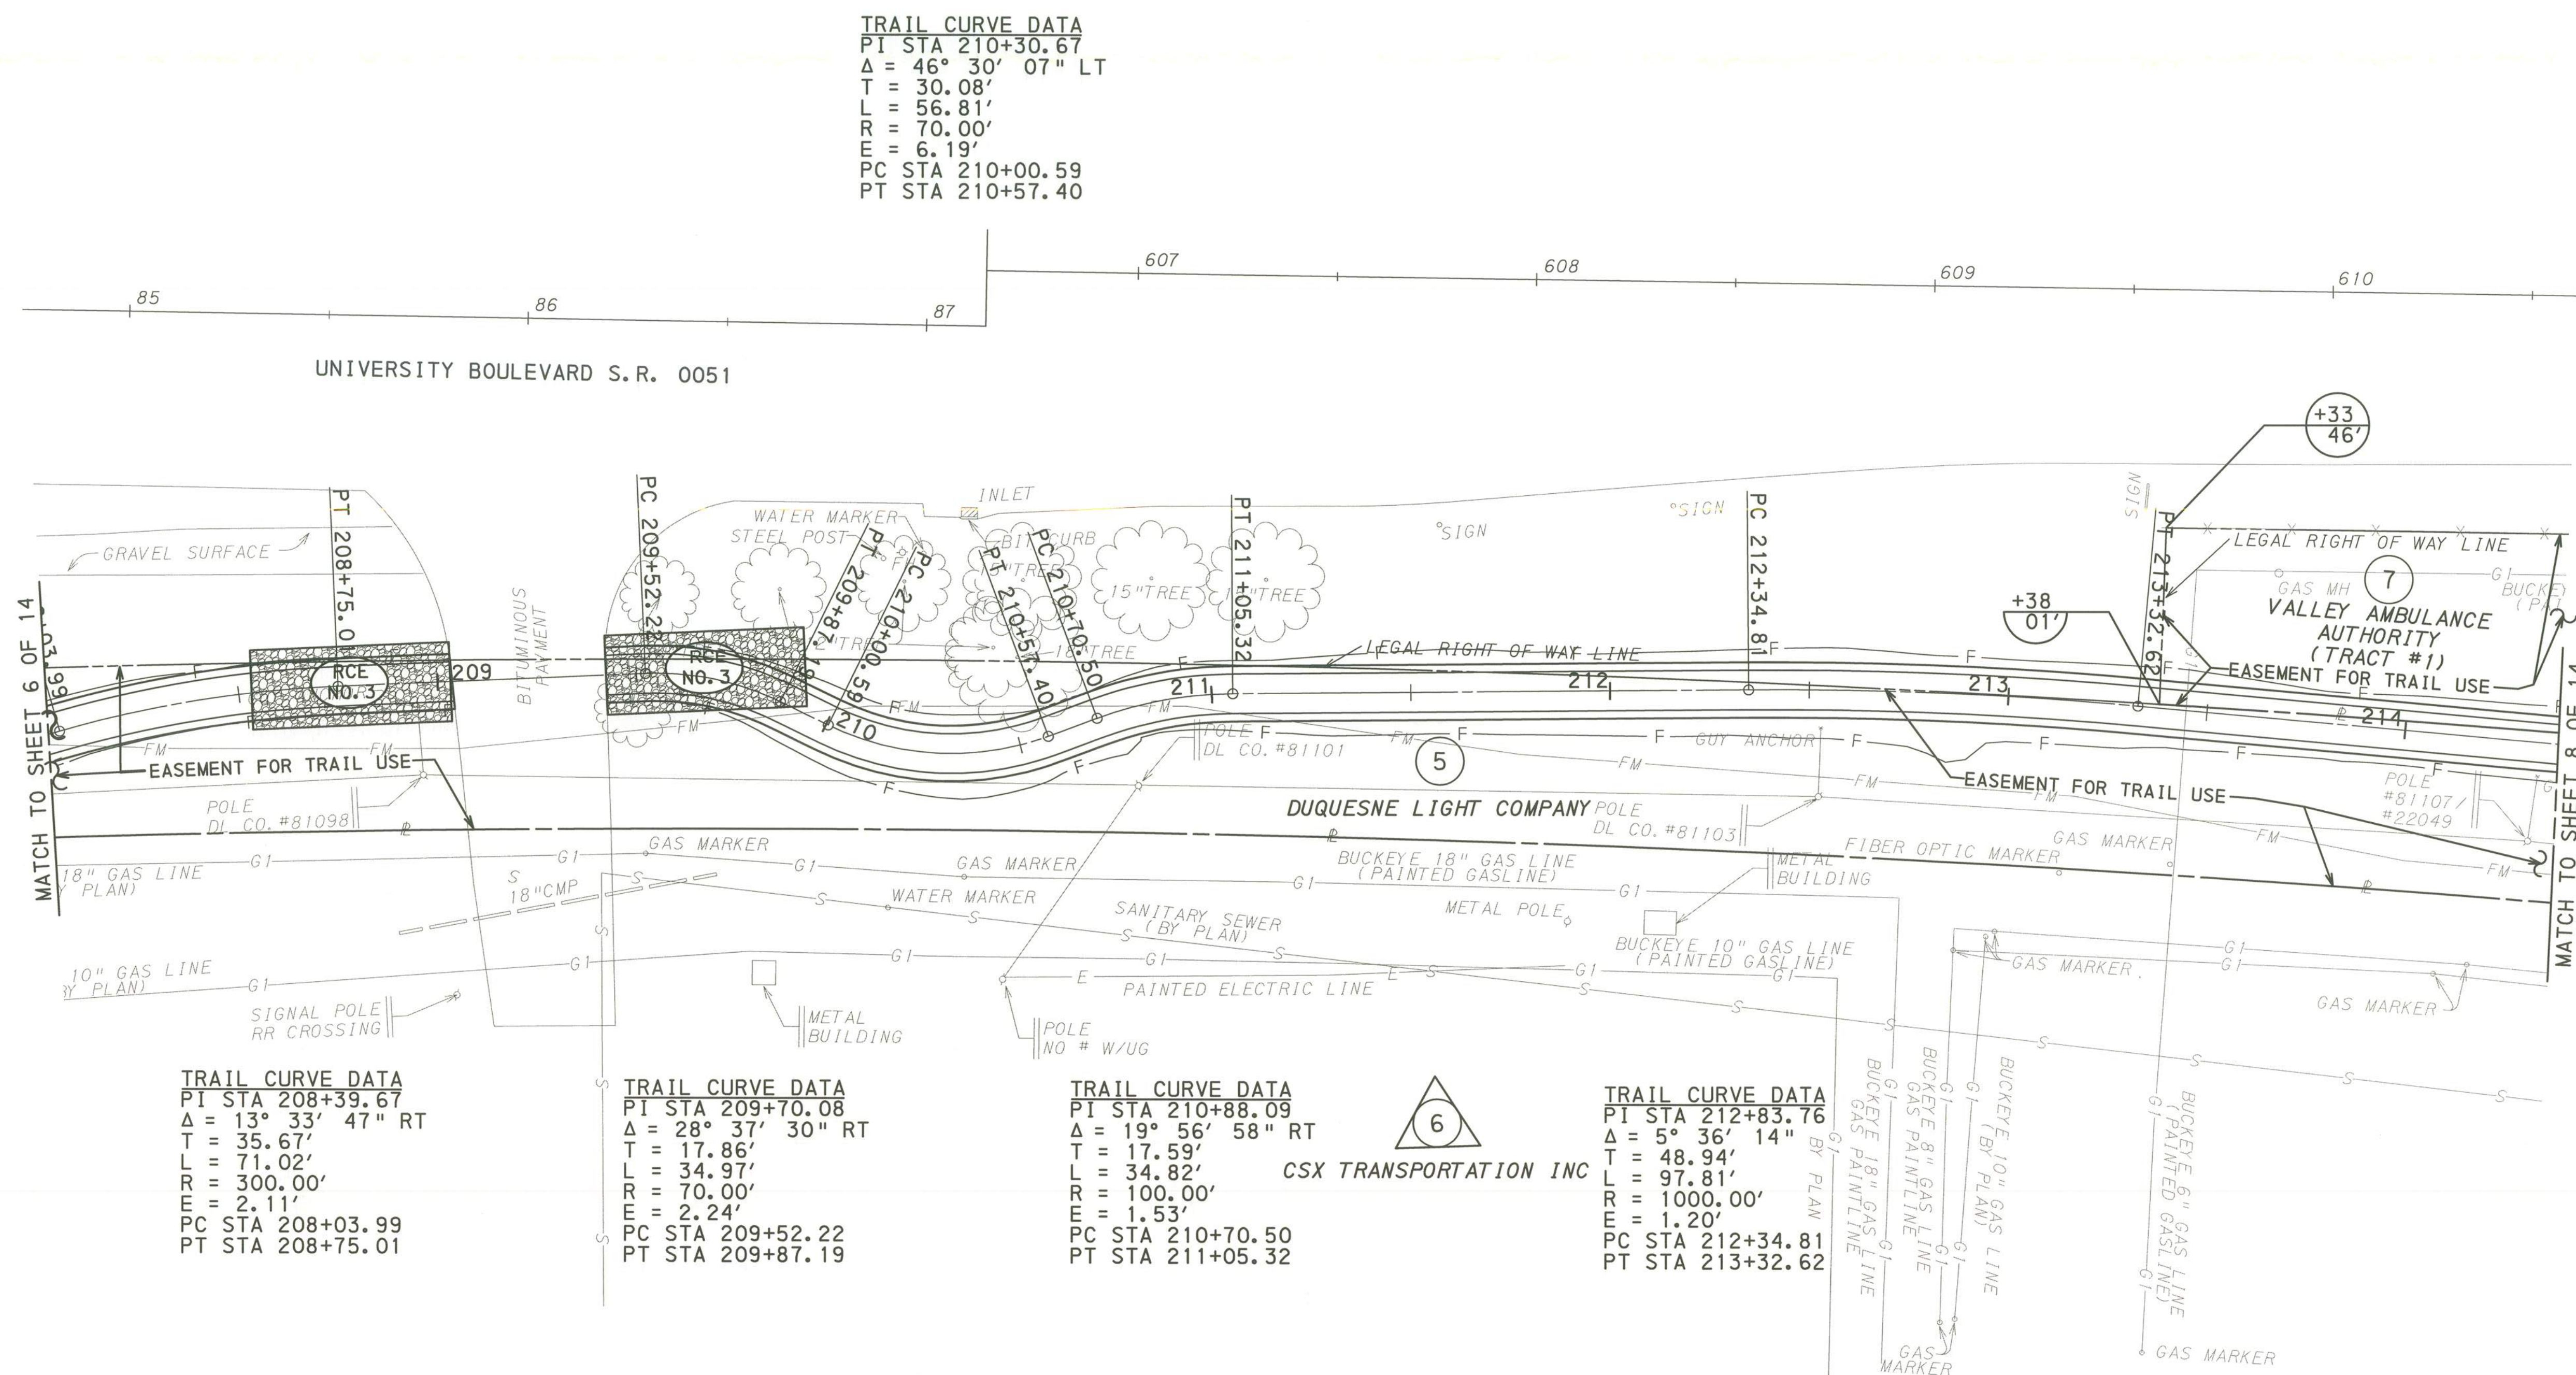


LEGEND

- G -	GAS LINE	- GV -	GAS VALVE	- MH -	MANHOLE
- D -	DATA LINE	- GM -	GAS METER	⚙	LIGHT STANDARD
- T -	TELEPHONE LINE	- CO -	CLEAN OUT	- WB -	WATER BOX
- E -	ELECTRIC LINE	- FH -	FIRE HYDRANT	- WV -	WATER VALVE
- S -	SANITARY SEWER	- EB -	ELECTRIC BOX	- - -	EXISTING CONTOURS
==	STORM SEWER	- UG -	UNDERGROUND	- - -	EXISTING CONDITIONS (PAVEMENTS, WALKS, CURBS, ETC.)
				=====	PROPOSED IMPROVEMENTS


SCALE IN FEET

0 25 50

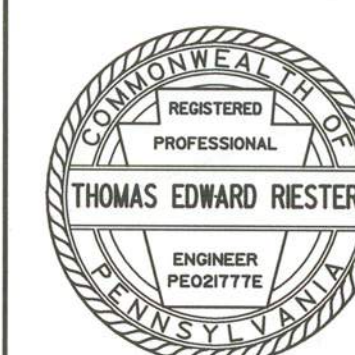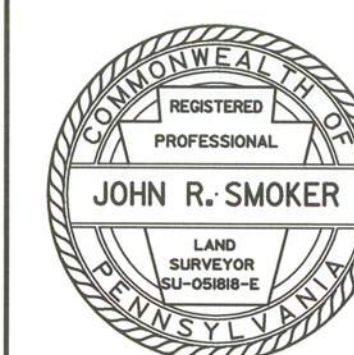

DISTRICT	COUNTY	ROUTE	SECTION	SHEET
11-0	ALLEGHENY	0051	A93 R/W	8 OF 14
MOON TOWNSHIP				
REVISION NUMBER	REVISIONS			DATE BY

TRAIL CURVE DATA
PI STA 215+91.99
 $\Delta = 10^\circ 35' 11''$ LT
T = 92.65'
L = 184.77'
R = 1000.00'
E = 4.28'
PC STA 214+99.34
PT STA 216+84.11

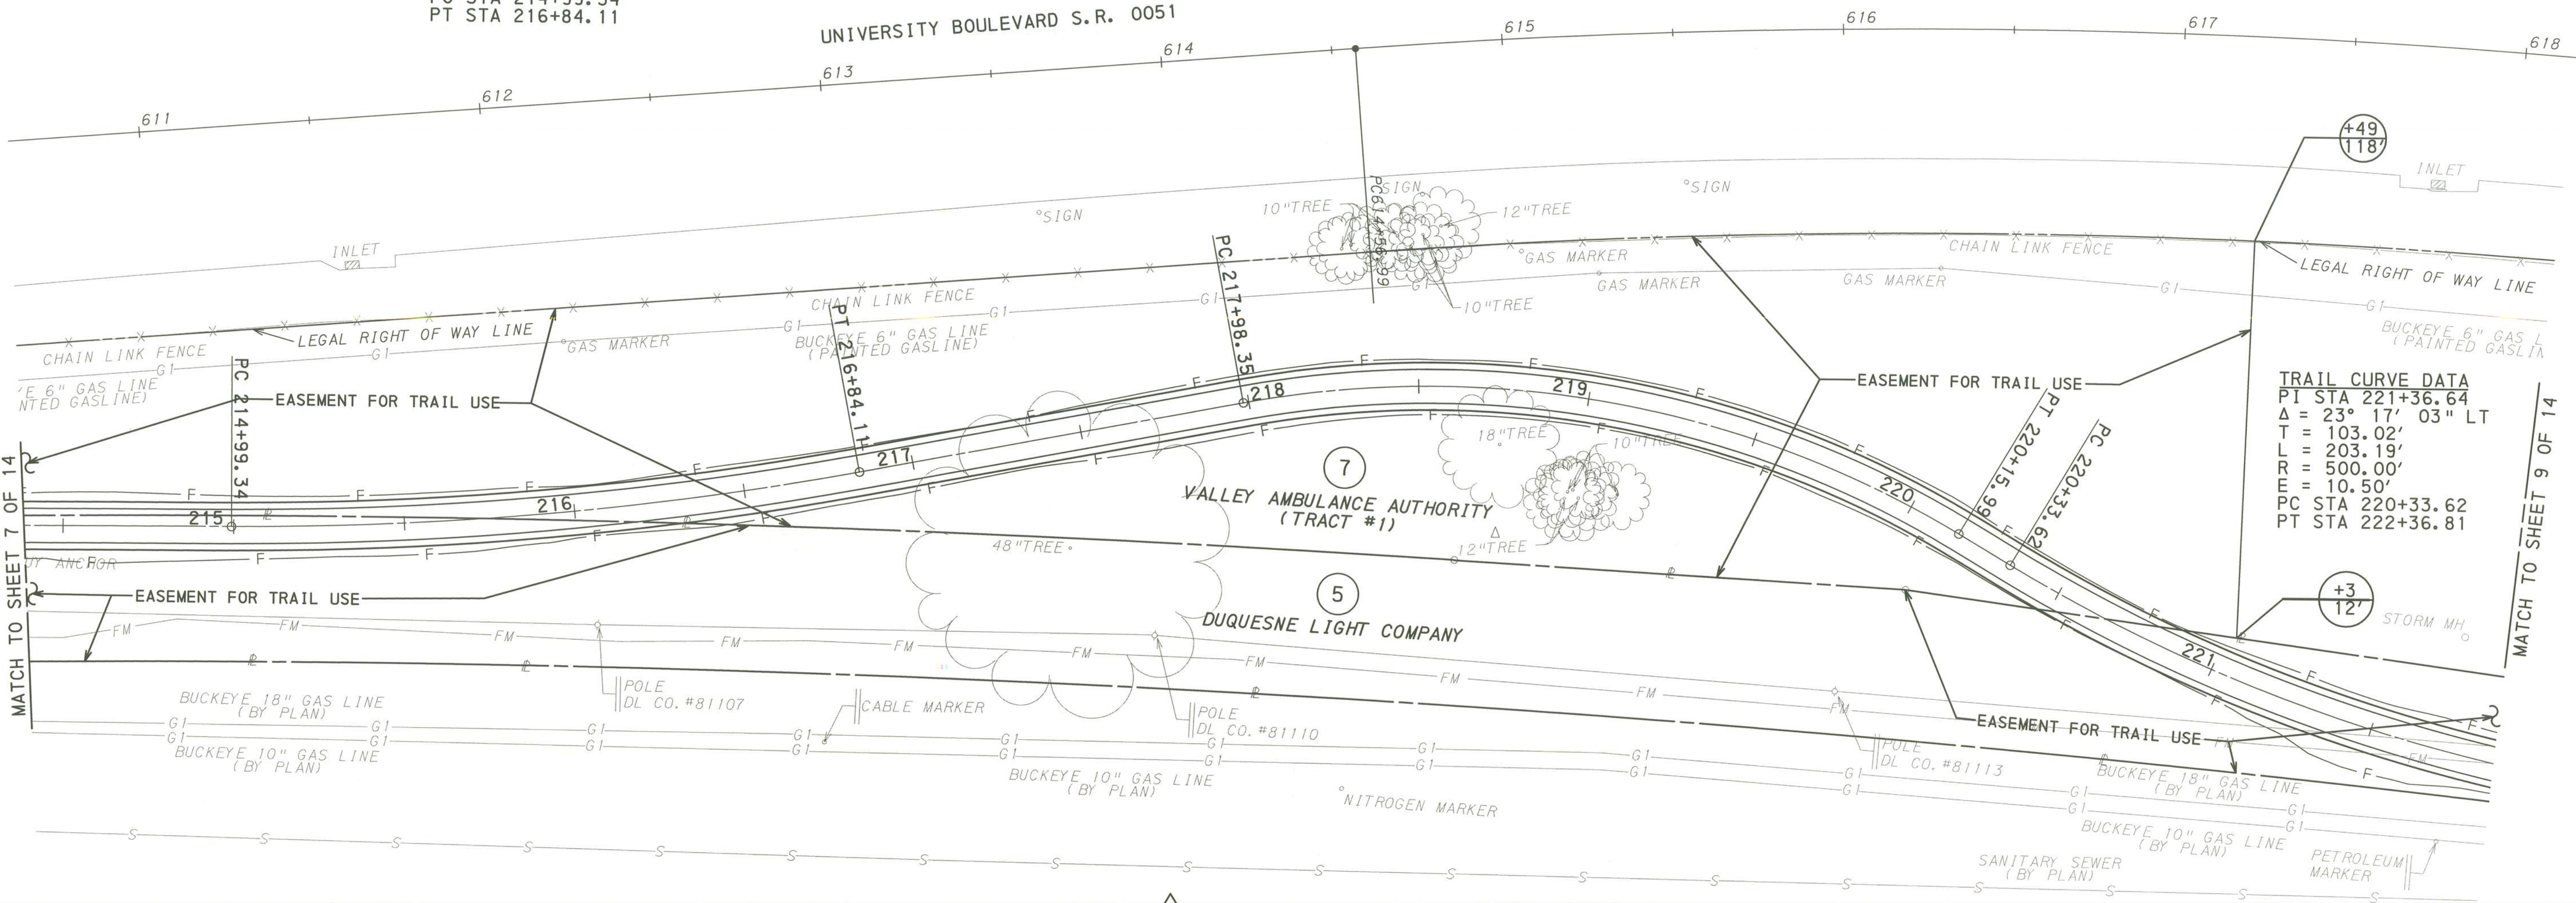



TRAIL CURVE DATA
PI STA 221+36.64
 $\Delta = 23^\circ 17' 03''$ LT
T = 103.02'
L = 203.19'
R = 500.00'
E = 10.50'
PC STA 220+33.62
PT STA 222+36.81

TRAIL CURVE DATA
PI STA 219+12.21
 $\Delta = 41^\circ 33' 56''$ RT
T = 113.86'
L = 217.64'
R = 300.00'
E = 20.88'
PC STA 217+98.35
PT STA 220+15.99


CSX TRANSPORTATION INC

LEGEND

- | | | |
|----------------------|---------------------|--|
| - G - GAS LINE | - GV - GAS VALVE | - MH - MANHOLE |
| - D - DATA LINE | - GM - GAS METER | - LS - LIGHT STANDARD |
| - T - TELEPHONE LINE | - CO - CLEAN OUT | - WB - WATER BOX |
| - E - ELECTRIC LINE | - FH - FIRE HYDRANT | - WV - WATER VALVE |
| - S - SANITARY SEWER | - EB - ELECTRIC BOX | - EC - EXISTING CONTOURS |
| - SS - STORM SEWER | - UG - UNDERGROUND | - EC - EXISTING CONDITIONS (PAVEMENTS, WALKS, CURBS, ETC.) |
| | | - PI - PROPOSED IMPROVEMENTS |


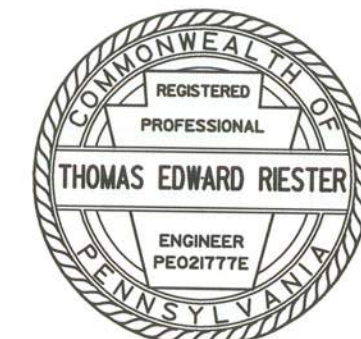
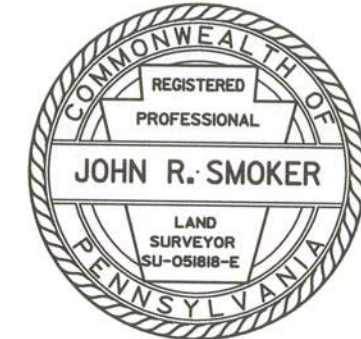



DISTRICT	COUNTY	ROUTE	SECTION	SHEET	
11-0	ALLEGHENY	0051	A93 R/W	9 OF 14	
MOON TOWNSHIP					
REVISION NUMBER	REVISIONS			DATE	BY

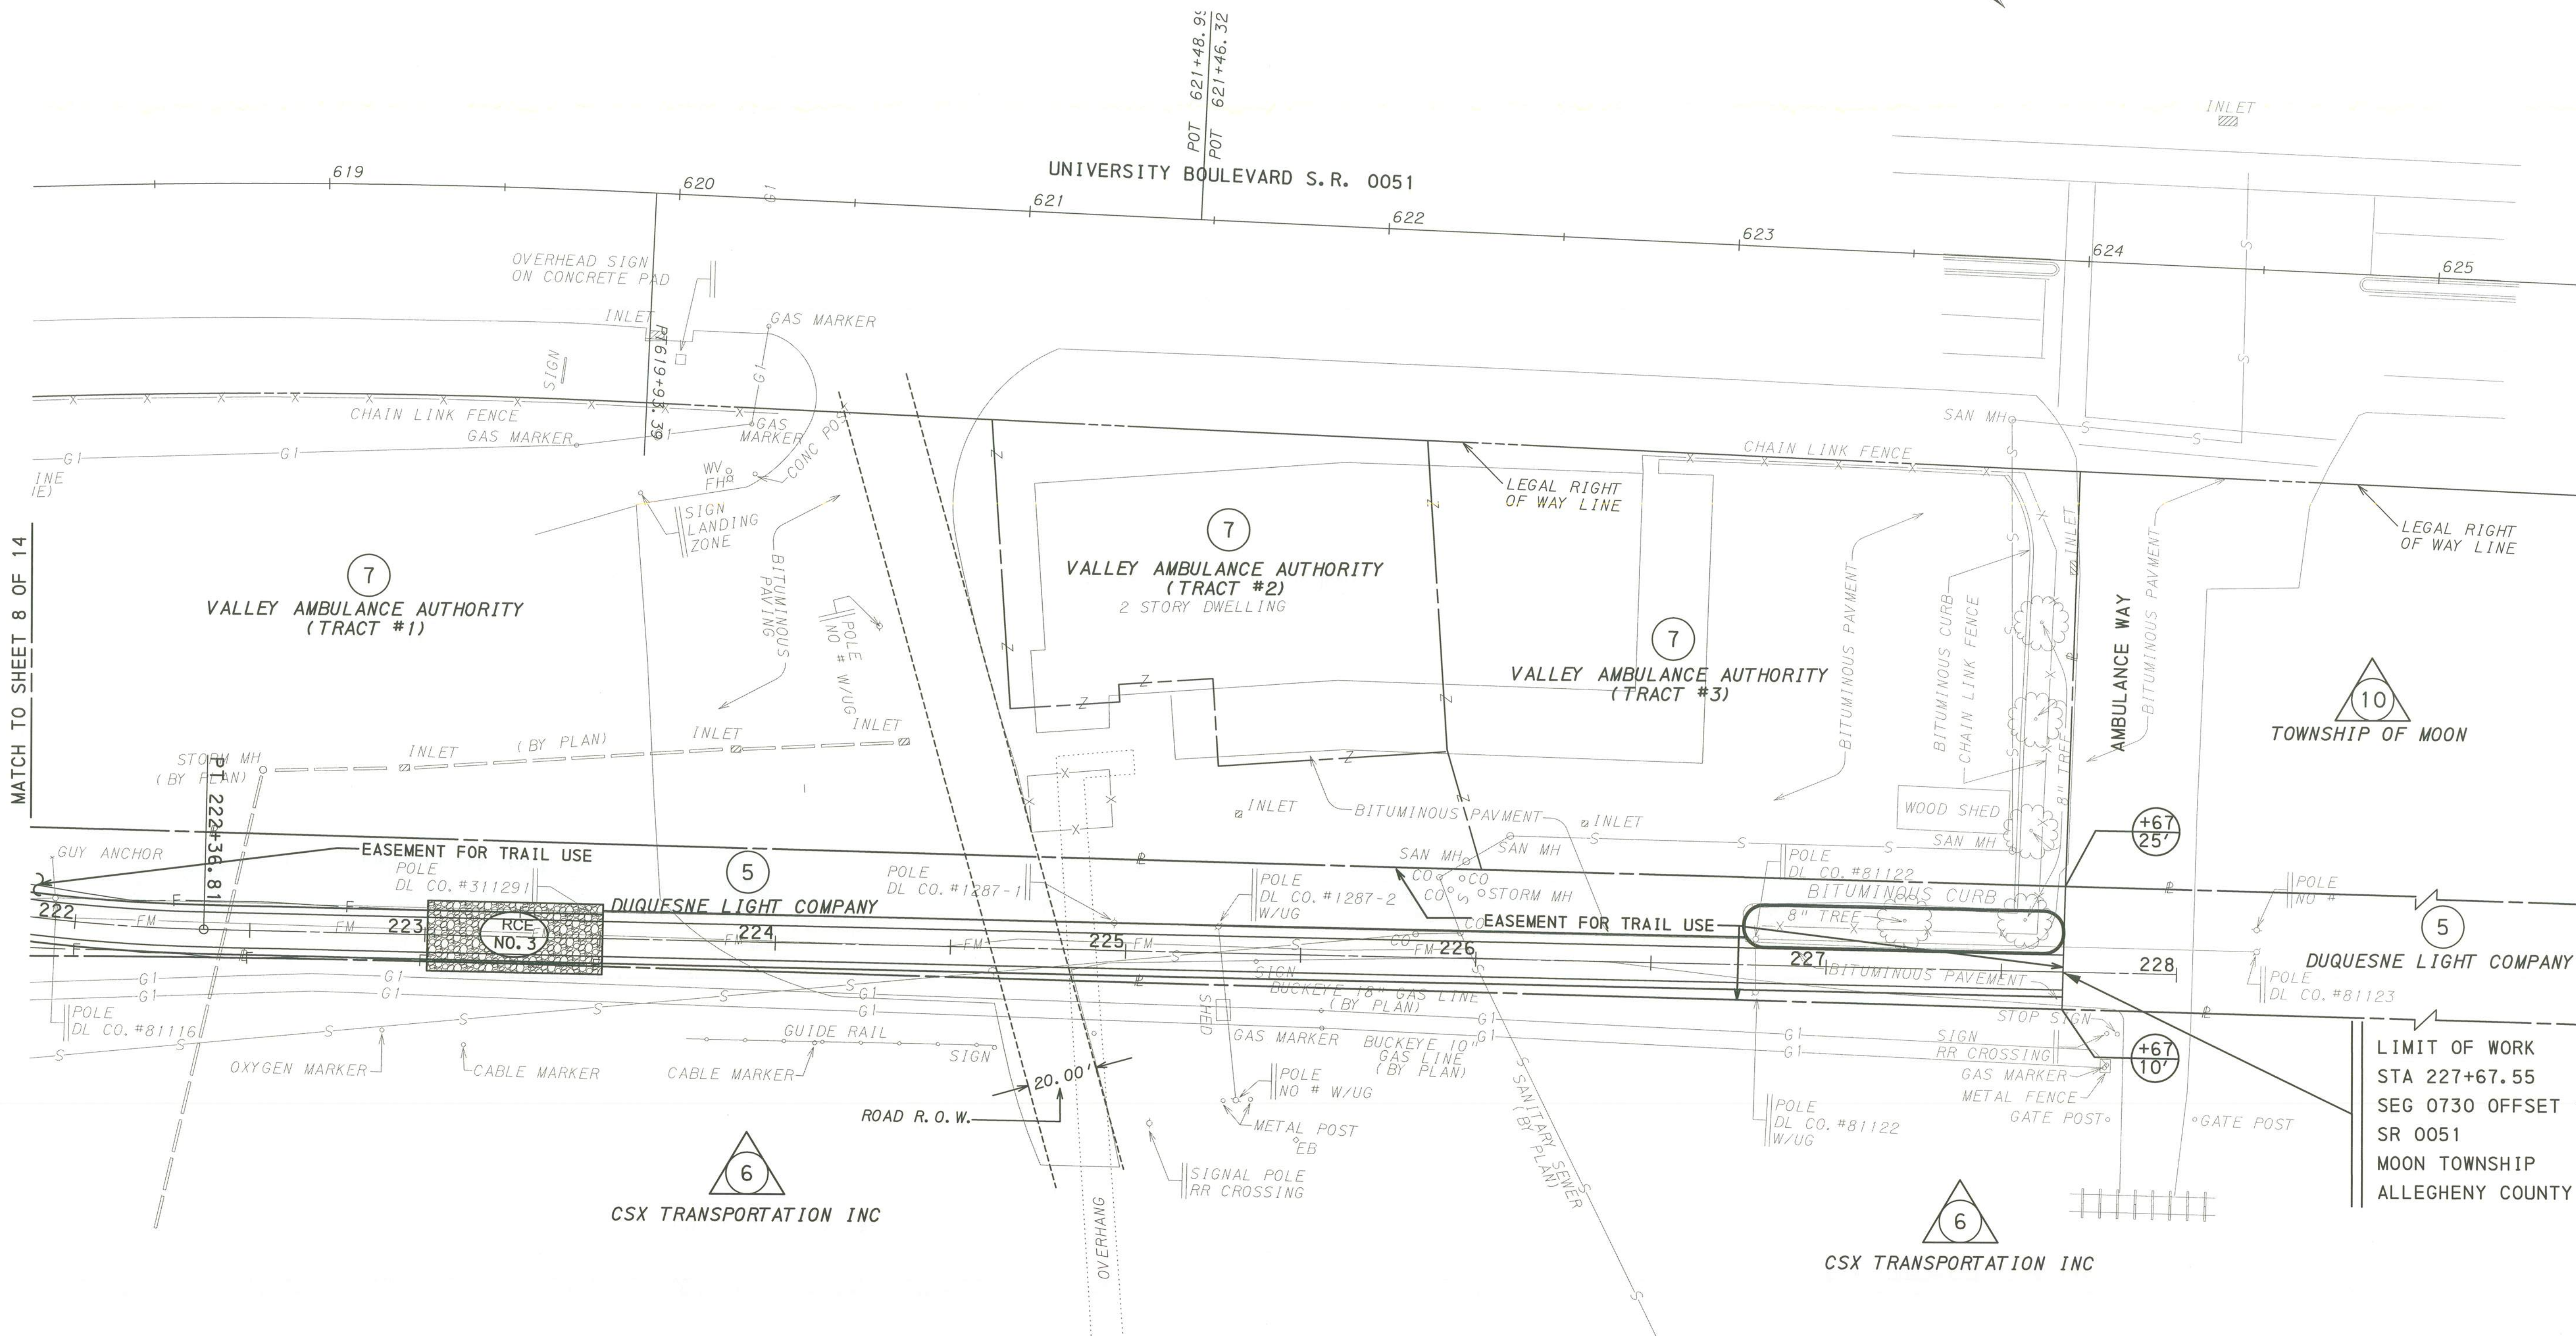

LEGEND

- G -	GAS LINE	- GV -	GAS VALVE	- MH -	MANHOLE
- D -	DATA LINE	- GM -	GAS METER	- LS -	LIGHT STANDARD
- T -	TELEPHONE LINE	- CO -	CLEAN OUT	- WB -	WATER BOX
- E -	ELECTRIC LINE	- FH -	FIRE HYDRANT	- WV -	WATER VALVE
- S -	SANITARY SEWER	- EB -	ELECTRIC BOX	- EC -	EXISTING CONTOURS
- SS -	STORM SEWER	- UG -	UNDERGROUND	- EX -	EXISTING CONDITIONS (PAVEMENTS, WALKS, CURBS, ETC.)
- PR -	PROPOSED IMPROVEMENTS				

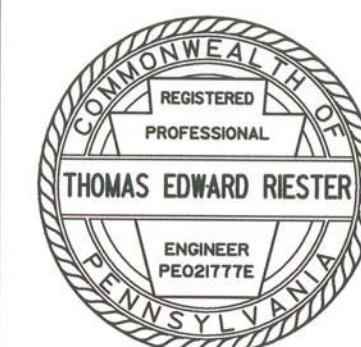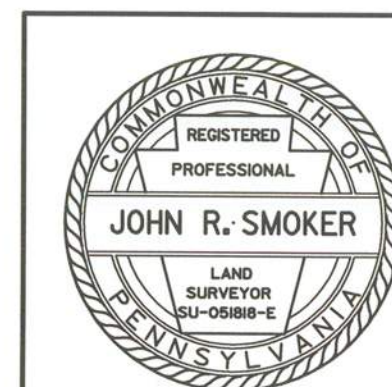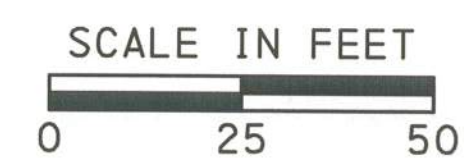

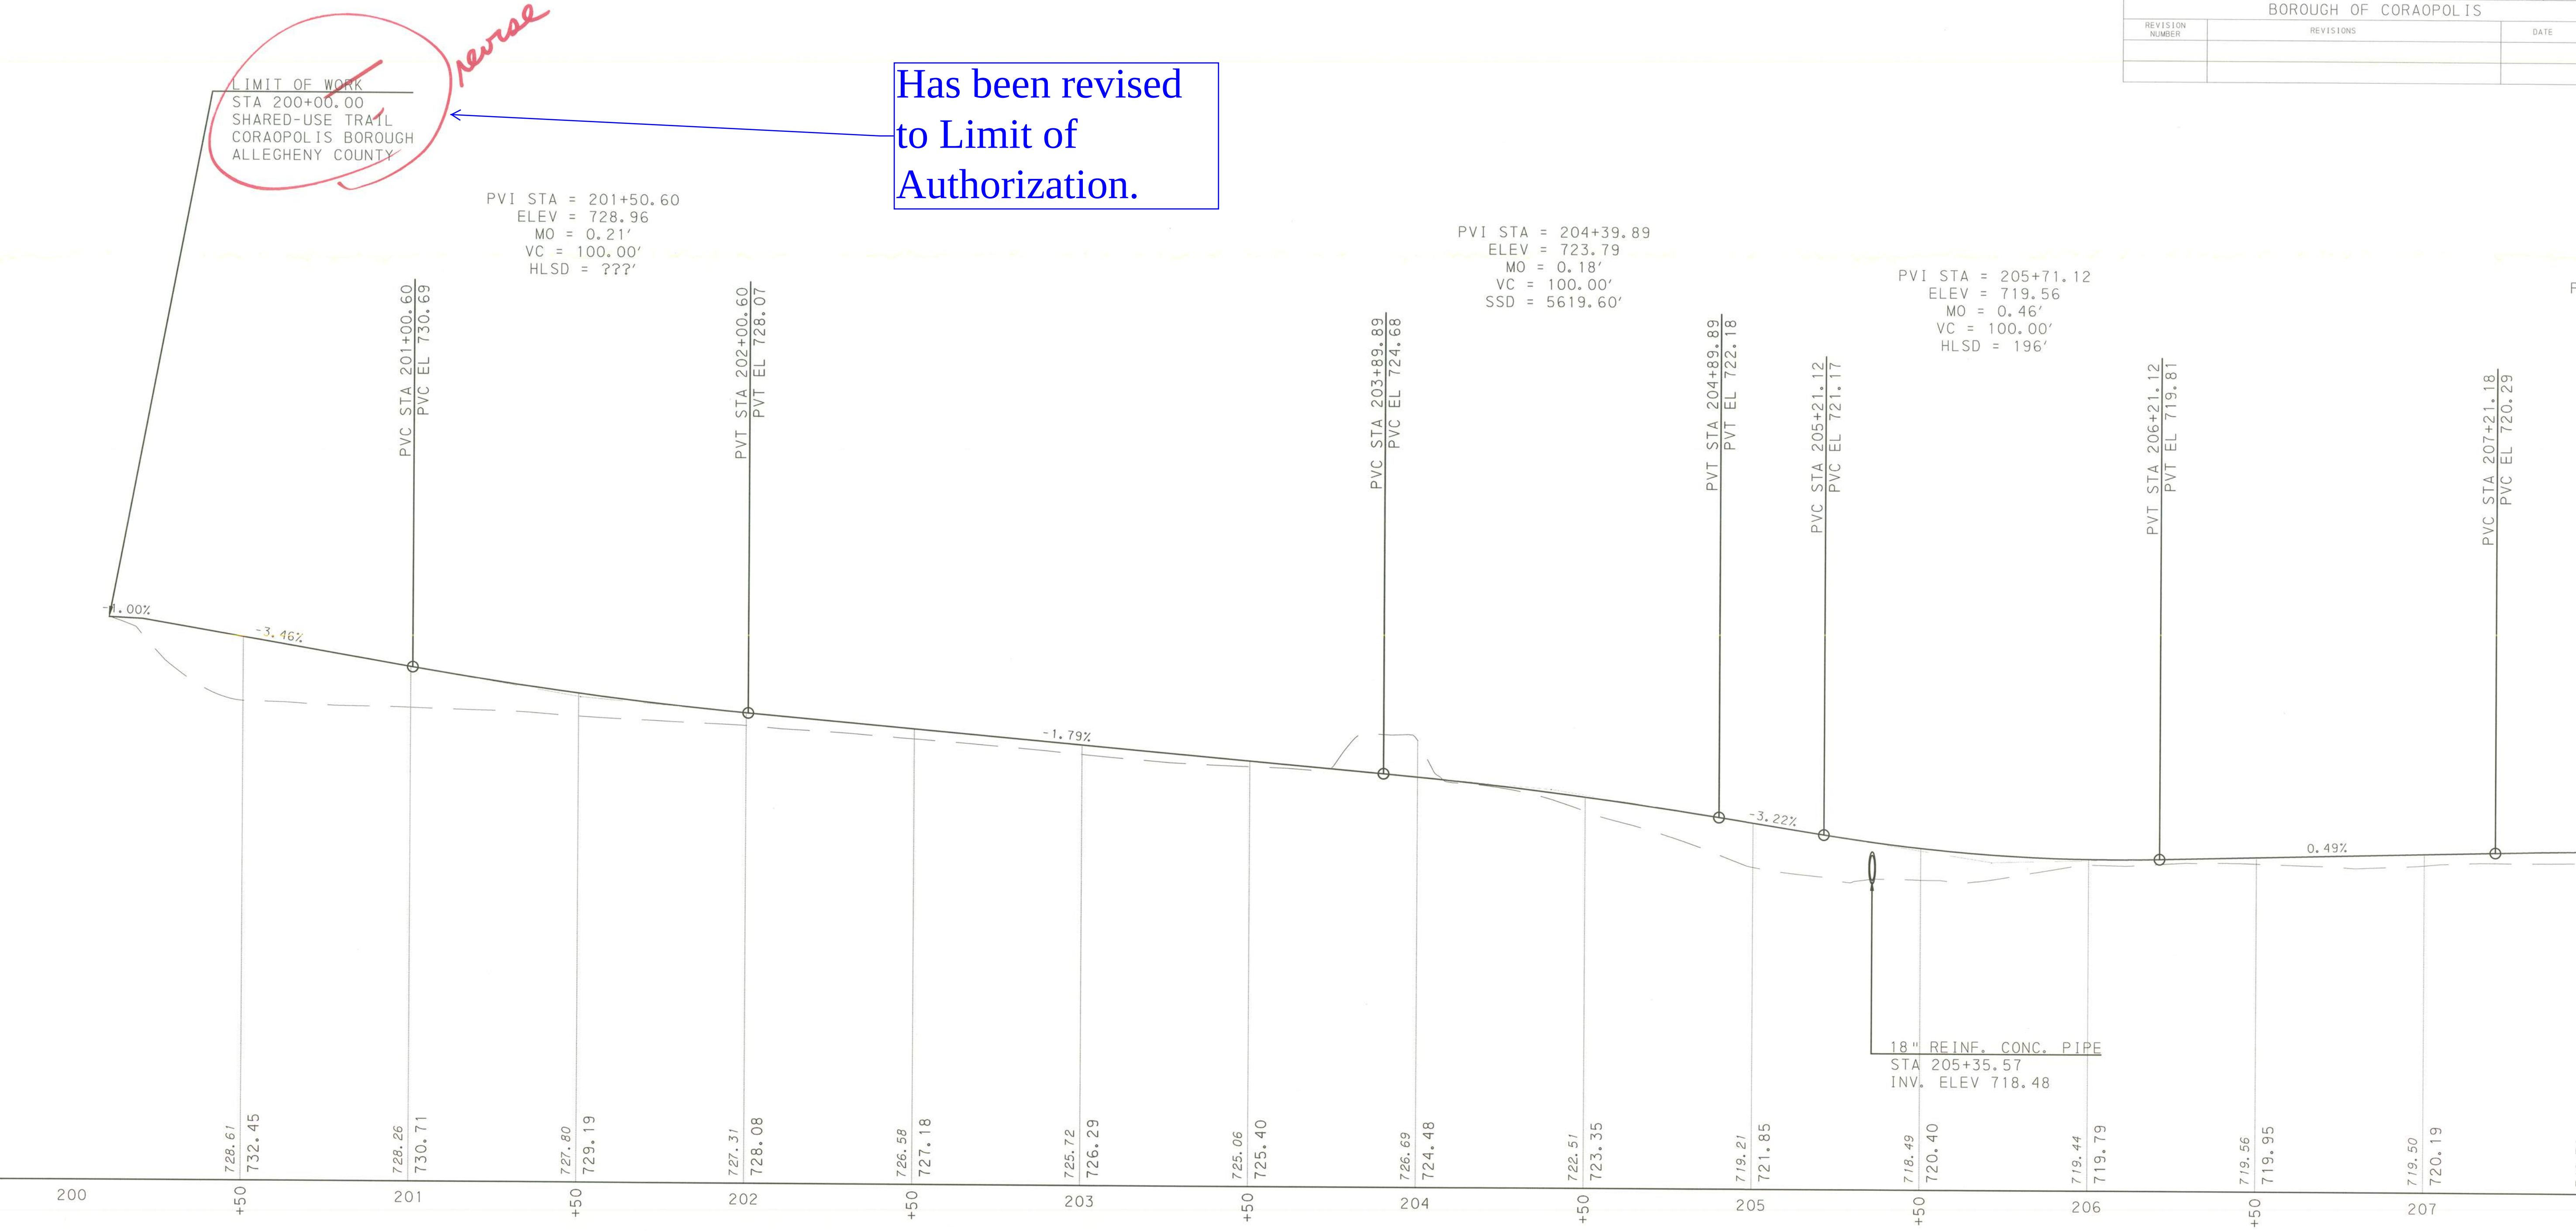


LIMIT OF WORK
STA 200+00.00
SHARED-USE TRAIL
CORAOPOLIS BOROUGH
ALLEGHENY COUNTY

reverse


Has been revised
to Limit of
Authorization.

SHARED-USE TRAIL PROFILE

Has been revised
to Ohio River
Trail Phase 1

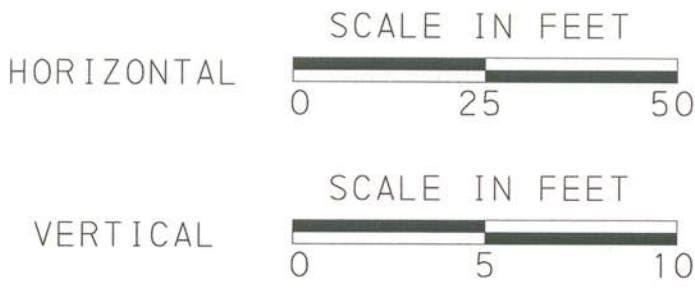


DISTRICT	COUNTY	ROUTE	SECTION	SHEET
11-0	ALLEGHENY	0051	A93 R/W	11 OF 14
BOROUGH OF CORAOPOLIS				
REVISION NUMBER	REVISIONS		DATE	BY

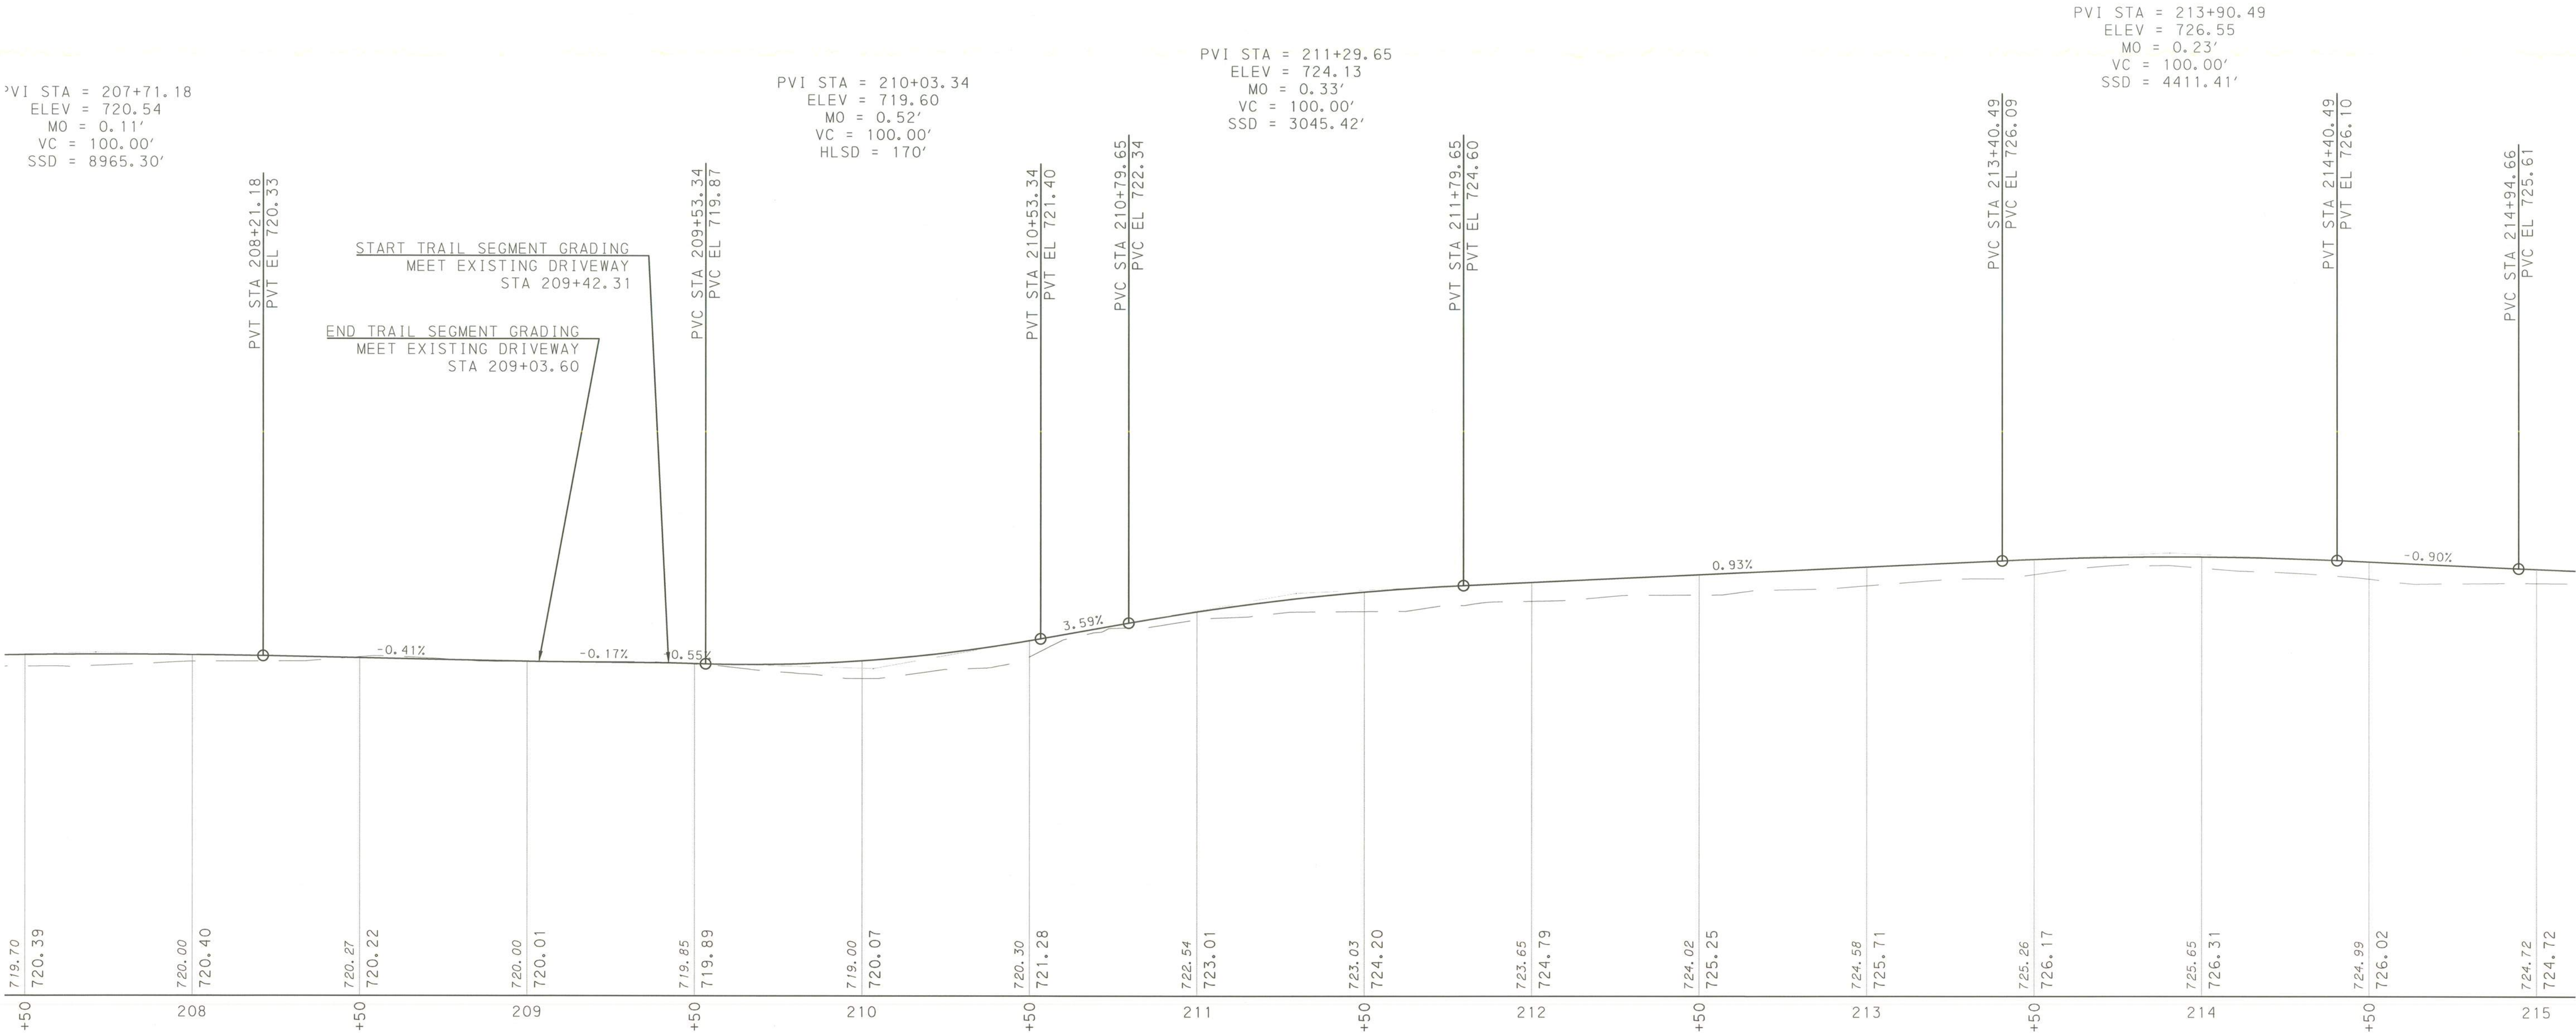


SHARED-USE TRAIL PROFILE


Has been revised
to Ohio River
Trail Phase 1

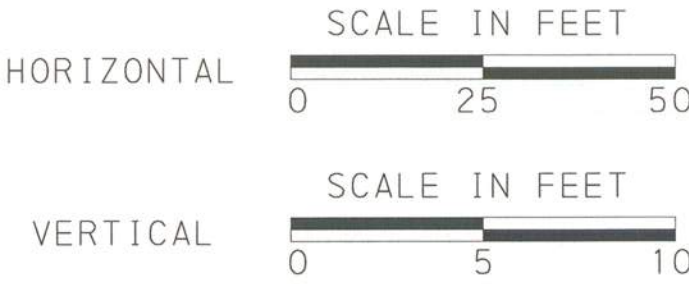

DISTRICT	COUNTY	ROUTE	SECTION	SHEET
11-0	ALLEGHENY	0051	A93 R/W	12 OF 14
BOROUGH OF CORAOPOLIS				
REVISION NUMBER	REVISIONS			DATE

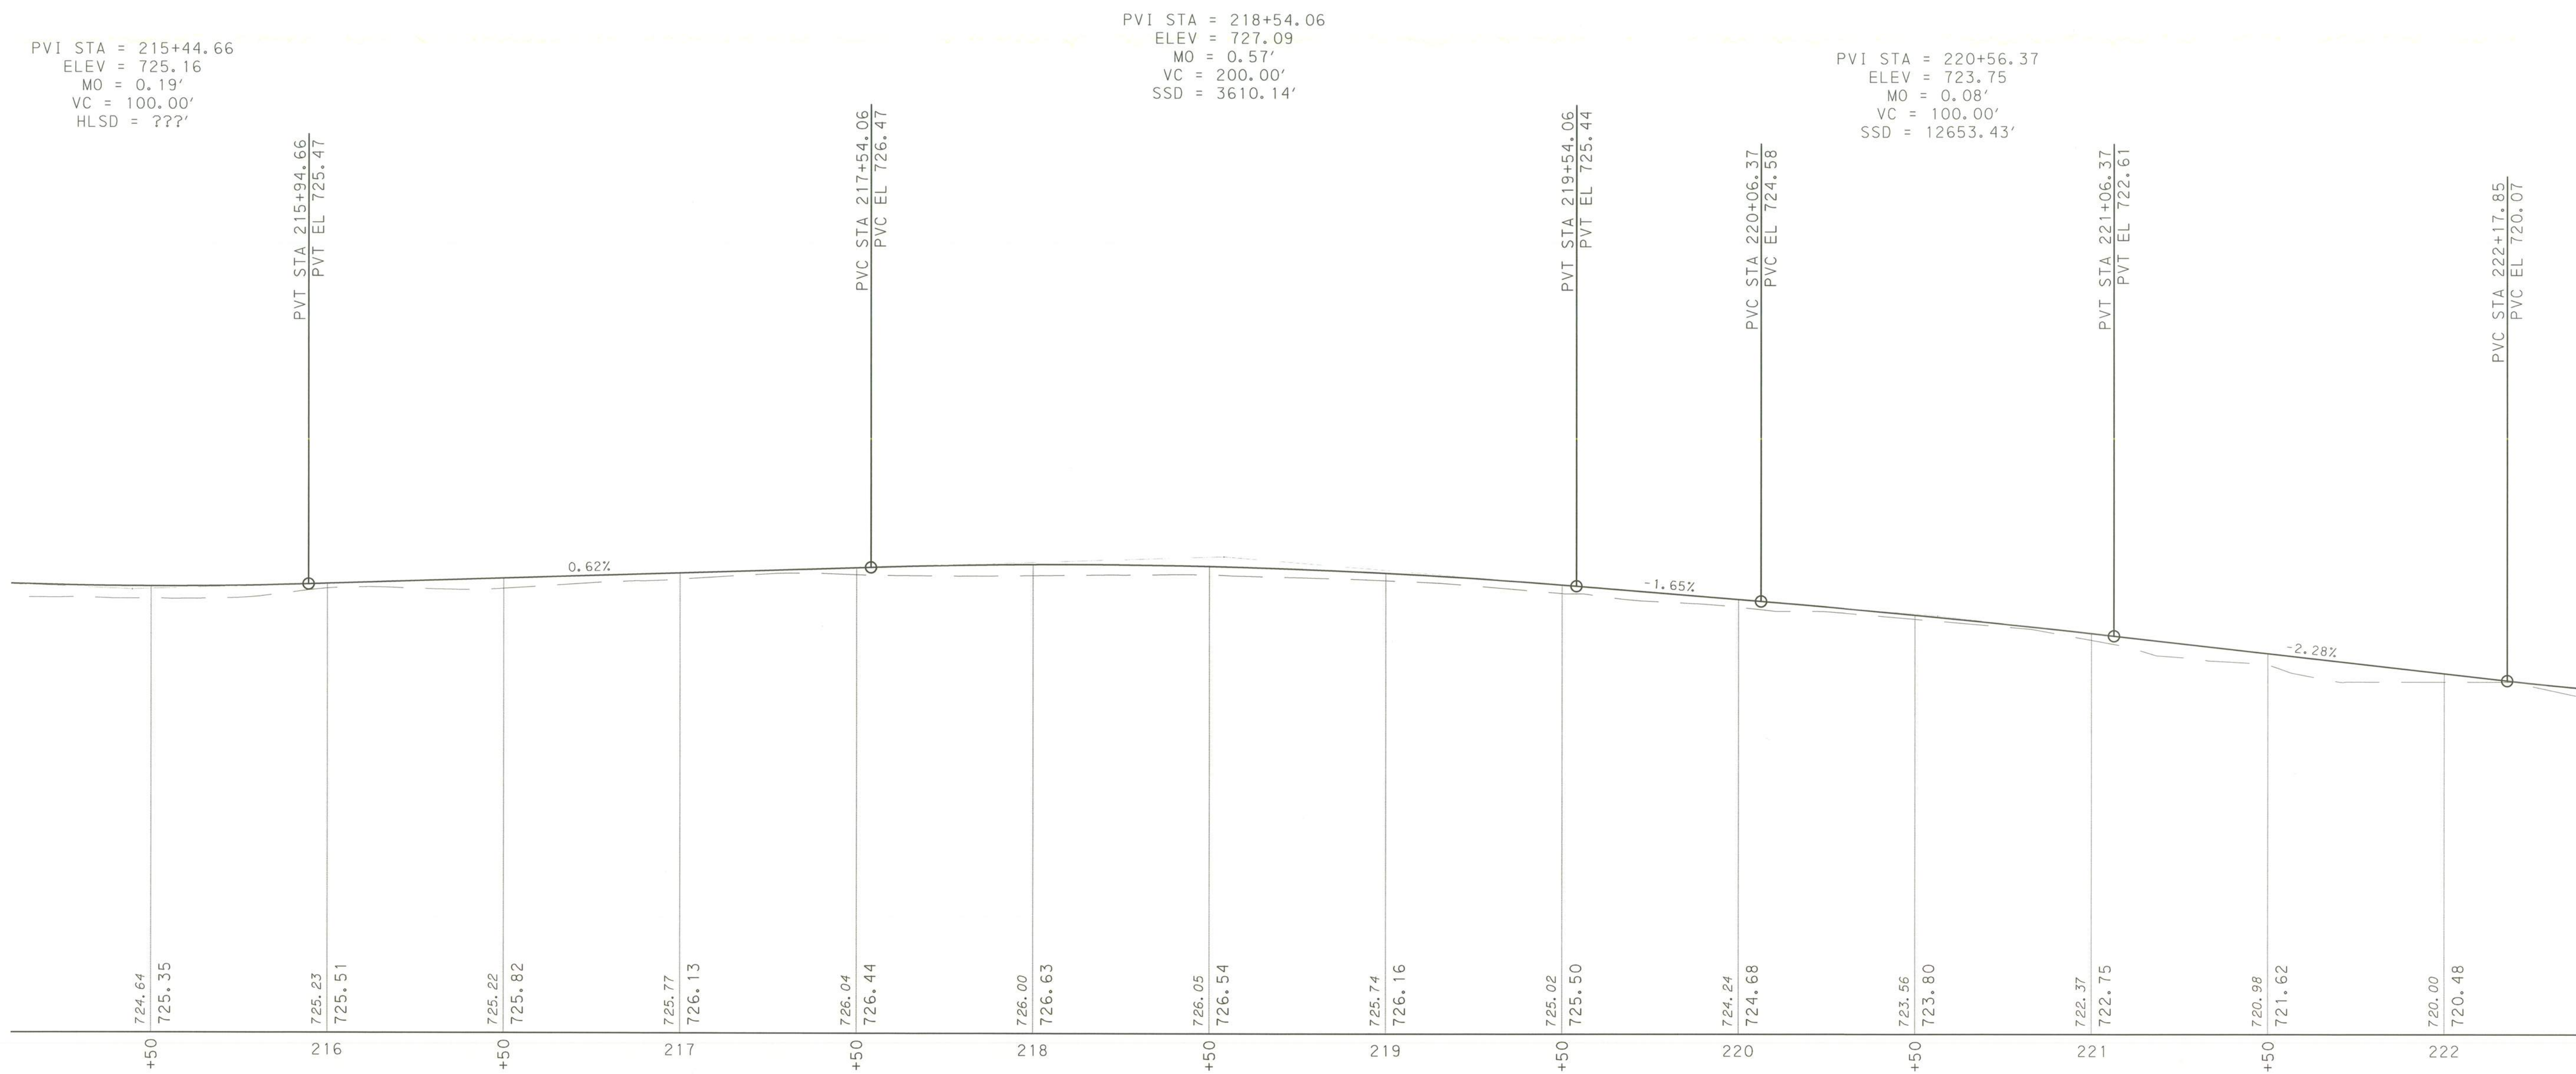

SHARED-USE TRAIL PROFILE

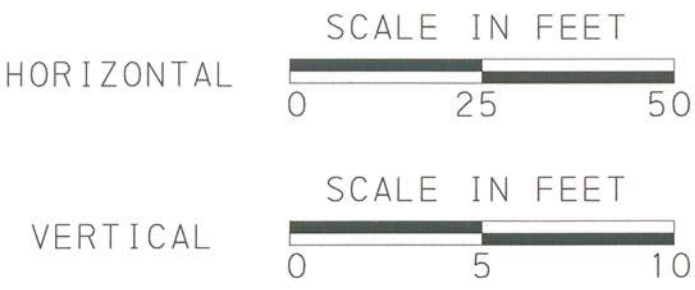

DISTRICT	COUNTY	ROUTE	SECTION	SHEET
11-0	ALLEGHENY	0051	A93 R/W	13 OF 14
BOROUGH OF CORAOPOLIS				
REVISION NUMBER	REVISIONS	DATE	BY	

PVI STA = 222+67.85
ELEV = 718.93
MO = 0.29'
VC = 100.00'
HLSD = 559'


PVT STA 223+17.85
PVT EL 718.94

MATCH EXISTING LOT PAVEMENT ELEV
STA 223+97.00

0.03%



SHARED-USE TRAIL PROFILE

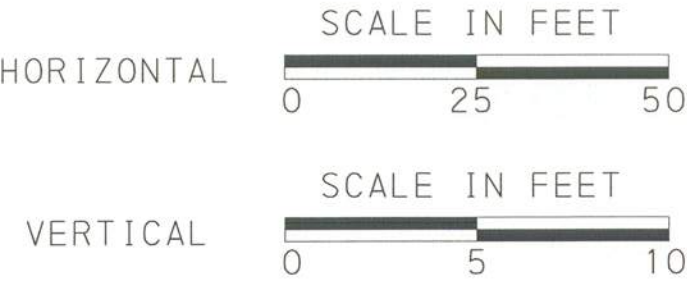

GRAVEL ACCESS ROAD PROFILE

LIMIT OF WORK
STA 1000+00.00
GRAVEL ACCESS ROAD
CORAOPOLIS BOROUGH
ALLEGHENY COUNTY

PVI STA = 1000+32.94
ELEV = 720.39
MO = 0.16'
VC = 37.89'
HLSD = 162'

PVC STA 1000+14.00
PVC EL 720.89

PVT STA 1000+51.89
PVT EL 720.53

PVC STA 1000+67.83
PVC EL 720.65

PVT STA 1000+87.83
PVT EL 720.21

+2.62%

0.75%

-4.54%

LIMIT OF WORK
STA 1001+47.09
GRAVEL ACCESS ROAD
CORAOPOLIS BOROUGH
ALLEGHENY COUNTY

Has been revised
to Limit of
Authorization.

LIMIT OF WORK
STA 227+67.55
SHARED-USE TRAIL
CORAOPOLIS BOROUGH
ALLEGHENY COUNTY

DISTRICT	COUNTY	ROUTE	SECTION	SHEET
11-0	ALLEGHENY	0051	A23 R/W	14 OF 14
MOON TOWNSHIP				
REVISION NUMBER	REVISIONS			DATE BY

modify

RIGHT-OF-WAY CLAIM INFORMATION

COMMONWEALTH OF PENNSYLVANIA - DEPARTMENT OF TRANSPORTATION
STATE RTE. 0051 SEC. NO. A23 R/W MOON TOWNSHIP ALLEGHENY COUNTY
PARCEL NO. 5 SHEET NO. 5-9 CLAIM NO.
PROPERTY OWNER(S) DUQUESNE LIGHT COMPANY
GRANTOR(S) PITTSBURGH RAILWAYS COMPANY

DEED BOOK VOLUME 3267	AREAS DEED 5.0793	REQUIRED AREA ACRE / SF 5,391
PAGE 226	CALCULATED	TRAIL USE EASEMENT 92,651
DATE OF DEED 06-19-1953	ADVERSES	
DATE OF RECORD 06-23-1953	LEGAL R/W	
CONSIDERATION \$23,340.20	EFFECTIVE	
P.R.T.T. N/A	TOTAL REQ'D R/W	VERIFICATION DATE 05-04-2017
TAX MAP PARCEL 0505-D-357	TOTAL RESIDUE	DRAWN BY MACKIN ENG. CO.
	RESIDUE LT	
	RESIDUE RT	SCALE AS SHOWN

fill in

PRIVATE PROPERTY LINES ARE PLOTTED FROM THE DEED OF RECORD, RECORDED SUBDIVISION OR LOT PLANS, EXISTING TOPOGRAPHICAL REATURES AND LIMITED FIELD DATA. PRIVATE PROPERTY LINES WERE NOT SURVEYED BY THE PROFESSIONAL LAND SURVEYOR RESPONSIBLE FOR THE PROJECT.

TEMPORARY CONSTRUCTION EASEMENT. AN EASEMENT TO USE THE LAND AS NECESSARY DURING CONSTRUCTION OF THE PROJECT. THE EASEMENT IS REQUIRED ONLY UNTIL THE CONSTRUCTION OR WORK INDICATED BY THE PLAN IS COMPLETED, UNLESS SOONER RELINQUISHED IN WRITING BY THE DEPARTMENT.

All Revisions have been made.

modify

RIGHT-OF-WAY CLAIM INFORMATION

COMMONWEALTH OF PENNSYLVANIA - DEPARTMENT OF TRANSPORTATION
STATE RTE. 0051 SEC. NO. A23 R/W MOON TOWNSHIP ALLEGHENY COUNTY
PARCEL NO. 7 SHEET NO. 7-9 CLAIM NO.
PROPERTY OWNER(S) VALLEY AMBULANCE AUTHORITY
GRANTOR(S) RB&W CORPORATION

TRACT #1	TRACT #2	TRACT #3	AREAS ACRE / SF 3.428	REQUIRED AREA ACRE / SF 1.325
DEED BOOK VOLUME 7953	DEED BOOK VOLUME 5445	DEED BOOK VOLUME 8542	DEED	TRAIL USE EASEMENT
PAGE 83	PAGE 223	PAGE 174	CALCULATED	
DATE OF DEED 01/27/1989	DATE OF DEED 12/24/1974	DATE OF DEED 04/28/1988	ADVERSES	
DATE OF RECORD 01/30/1989	DATE OF RECORD 12/30/1974	DATE OF RECORD 08/09/1991	LEGAL R/W	
CONSIDERATION \$20,000	CONSIDERATION \$0.0	CONSIDERATION \$50,000	EFFECTIVE	
P.R.T.T. \$200	P.R.T.T. \$0.0	P.R.T.T. \$500	TOTAL REQ'D R/W	VERIFICATION DATE 05-04-2017
TAX MAP PARCEL 505-D-371	TAX MAP PARCEL 505-H-316	TAX MAP PARCEL 505-H-318	TOTAL RESIDUE	DRAWN BY MACKIN ENG. CO.
			RESIDUE LT	
			RESIDUE RT	SCALE AS SHOWN

fill in

PRIVATE PROPERTY LINES ARE PLOTTED FROM THE DEED OF RECORD, RECORDED SUBDIVISION OR LOT PLANS, EXISTING TOPOGRAPHICAL REATURES AND LIMITED FIELD DATA. PRIVATE PROPERTY LINES WERE NOT SURVEYED BY THE PROFESSIONAL LAND SURVEYOR RESPONSIBLE FOR THE PROJECT.

